

Denver Public Schools Purchasing Department 1617 S. Acoma St. Denver, Colorado 80223

#### INVITATION TO BID 14-MC-2187 ADDENDUM NUMBER FIVE July 30, 2014

#### THIS ADDENDUM MUST BE ACKNOWLEDGED.

## NOTE: Bid date and time has changed to August 6, 2014 @ 11:00AM New bid tab attached dated August 6, 2014

ADMINISTRATIVE					
Item No.	Ref. Sheet	Description	Dwg. No.		
5-001	Vendor Acknowledement, Instructions to Bidders, Bid Form	The bid date has been changed to Wednesday, August 6 <sup>th</sup> at 11:00 a.m. Acoma Campus Conference Room 213			

PLUMBIN	PLUMBING				
Item No.	Ref. Sheet	Description	Dwg. No.		
5-002	P-102, P- 104, P-105, P-106, P- 112, p-113, P-300, P- 400, P-600	The Plumbing sheet attachments for Addendum 4 were inadvertently omitted from the issued attachments for that addendum. They are now being issued as part of Addendum 5, however the changes on the sheets still reference Addendum #4.	P-102, P- 104, P- 105, P- 106, P- 112, p- 113, P- 300, P- 400, P- 600		

If your proposal has been submitted and you wish to amend it, please modify your proposal on company letterhead. The amended proposal must be received prior to or included at the time and date set for the proposal opening. Each modification submitted to the District's Purchasing Office located at 1617 S. Acoma St. Denver, CO 80223. It must have Vendor's name and return address and the applicable RFP number and title of the RFP clearly marked on the face of the envelope.

If more than one modification is submitted, the modification bearing the latest date of receipt by the District's Strategic Sourcing Office will be considered the valid modification.

#### \*\*\*\*\*This addendum must be acknowledged, whether or not you amend your proposal.\*\*\*\*\*

### This Addendum must be included in your submittal or proposal, providing you do not need to amend your proposal. PRINT OR TYPE YOUR INFORMATION

Name of Company:	Fax:	
Address:	City/State:	
Contact Person:	Title:	Phone:
Authorized Representative's Signature:		Phone:
Printed Name:	Title:	Date:
	Approved by:	Date:
	Reviewed by:	Date:

#### **BID FORM**

**BASE BID** 

TO: SCHOOL DISTRICT NO 1 IN THE CITY AND COUNTY OF DENVER AND STATE OF COLORADO

PROJECT: Florence Crittenton Renovations Date: August 6, 2014


LOCATIONS: Florence Crittenton 55 S. Zuni St. Denver, CO 80223

Florence Crittenton 96 S. Zuni St. Denver, CO 80223

14-MC-2187

School	Bid Amount
F.C. H.S. Parcel A- Denver Public Schools High School Renovation /Addition – 55 S. Zuni Street Includes all associated work described within the	
bid documents for 55 South Zuni to construct and renovate the DPS Florence Crittenton High	
School. Please note G-103 Phasing Plan – Parcel A to be completed in Phase I.	\$
F.C. H.S. Parcel B- Florence Crittenton Services	δ
Renovation – 96 South Zuni Street	
Includes all associated work described within the bid documents for 96 South Zuni to renovate the	
Florence Crittenton Services ECE and offices. Please note G-103 Phasing Plan – Parcel B to be	
completed in Phase II and III.	\$
F.C. H.S Parcel C- Site Development / Improvements – 55 South Zuni Street and 96 South	
Zuni Street Includes all associated work in both 55 & 96 South	
Zuni bid documents specific to Civil, Landscape and Site Electrical.	
Please note G-103 Phasing Plan – Parcel C to be completed in Phase I and III.	
Completed in Fridase Fand III.	\$
Alternate 1 - Inclusion of the Aridus Rapid	
Drying Concrete	\$
Unit Price 1 – Price for vapor emission control	
treatment of floor slab, per 100 sq feet	
Xcel Rebate- DPS requires the selected contractor	
to utilize the Xcel Rebate Program and the Design	
Lights Consortium program for the following items: Mechanical - RTU, MAU, VFD, Pumps, Boilers,	
and Motors. Electrical - LED and low wattage T-8	
lighting, LED Exit Signs, Wall Packs, Canopy &	
Soffitt Fixtures, and Refrigerator Case Lighting.	
Provide an allowance for the anticipated rebate.	
·	\$

DPS will be awarding all Parcel projects to one vendor.

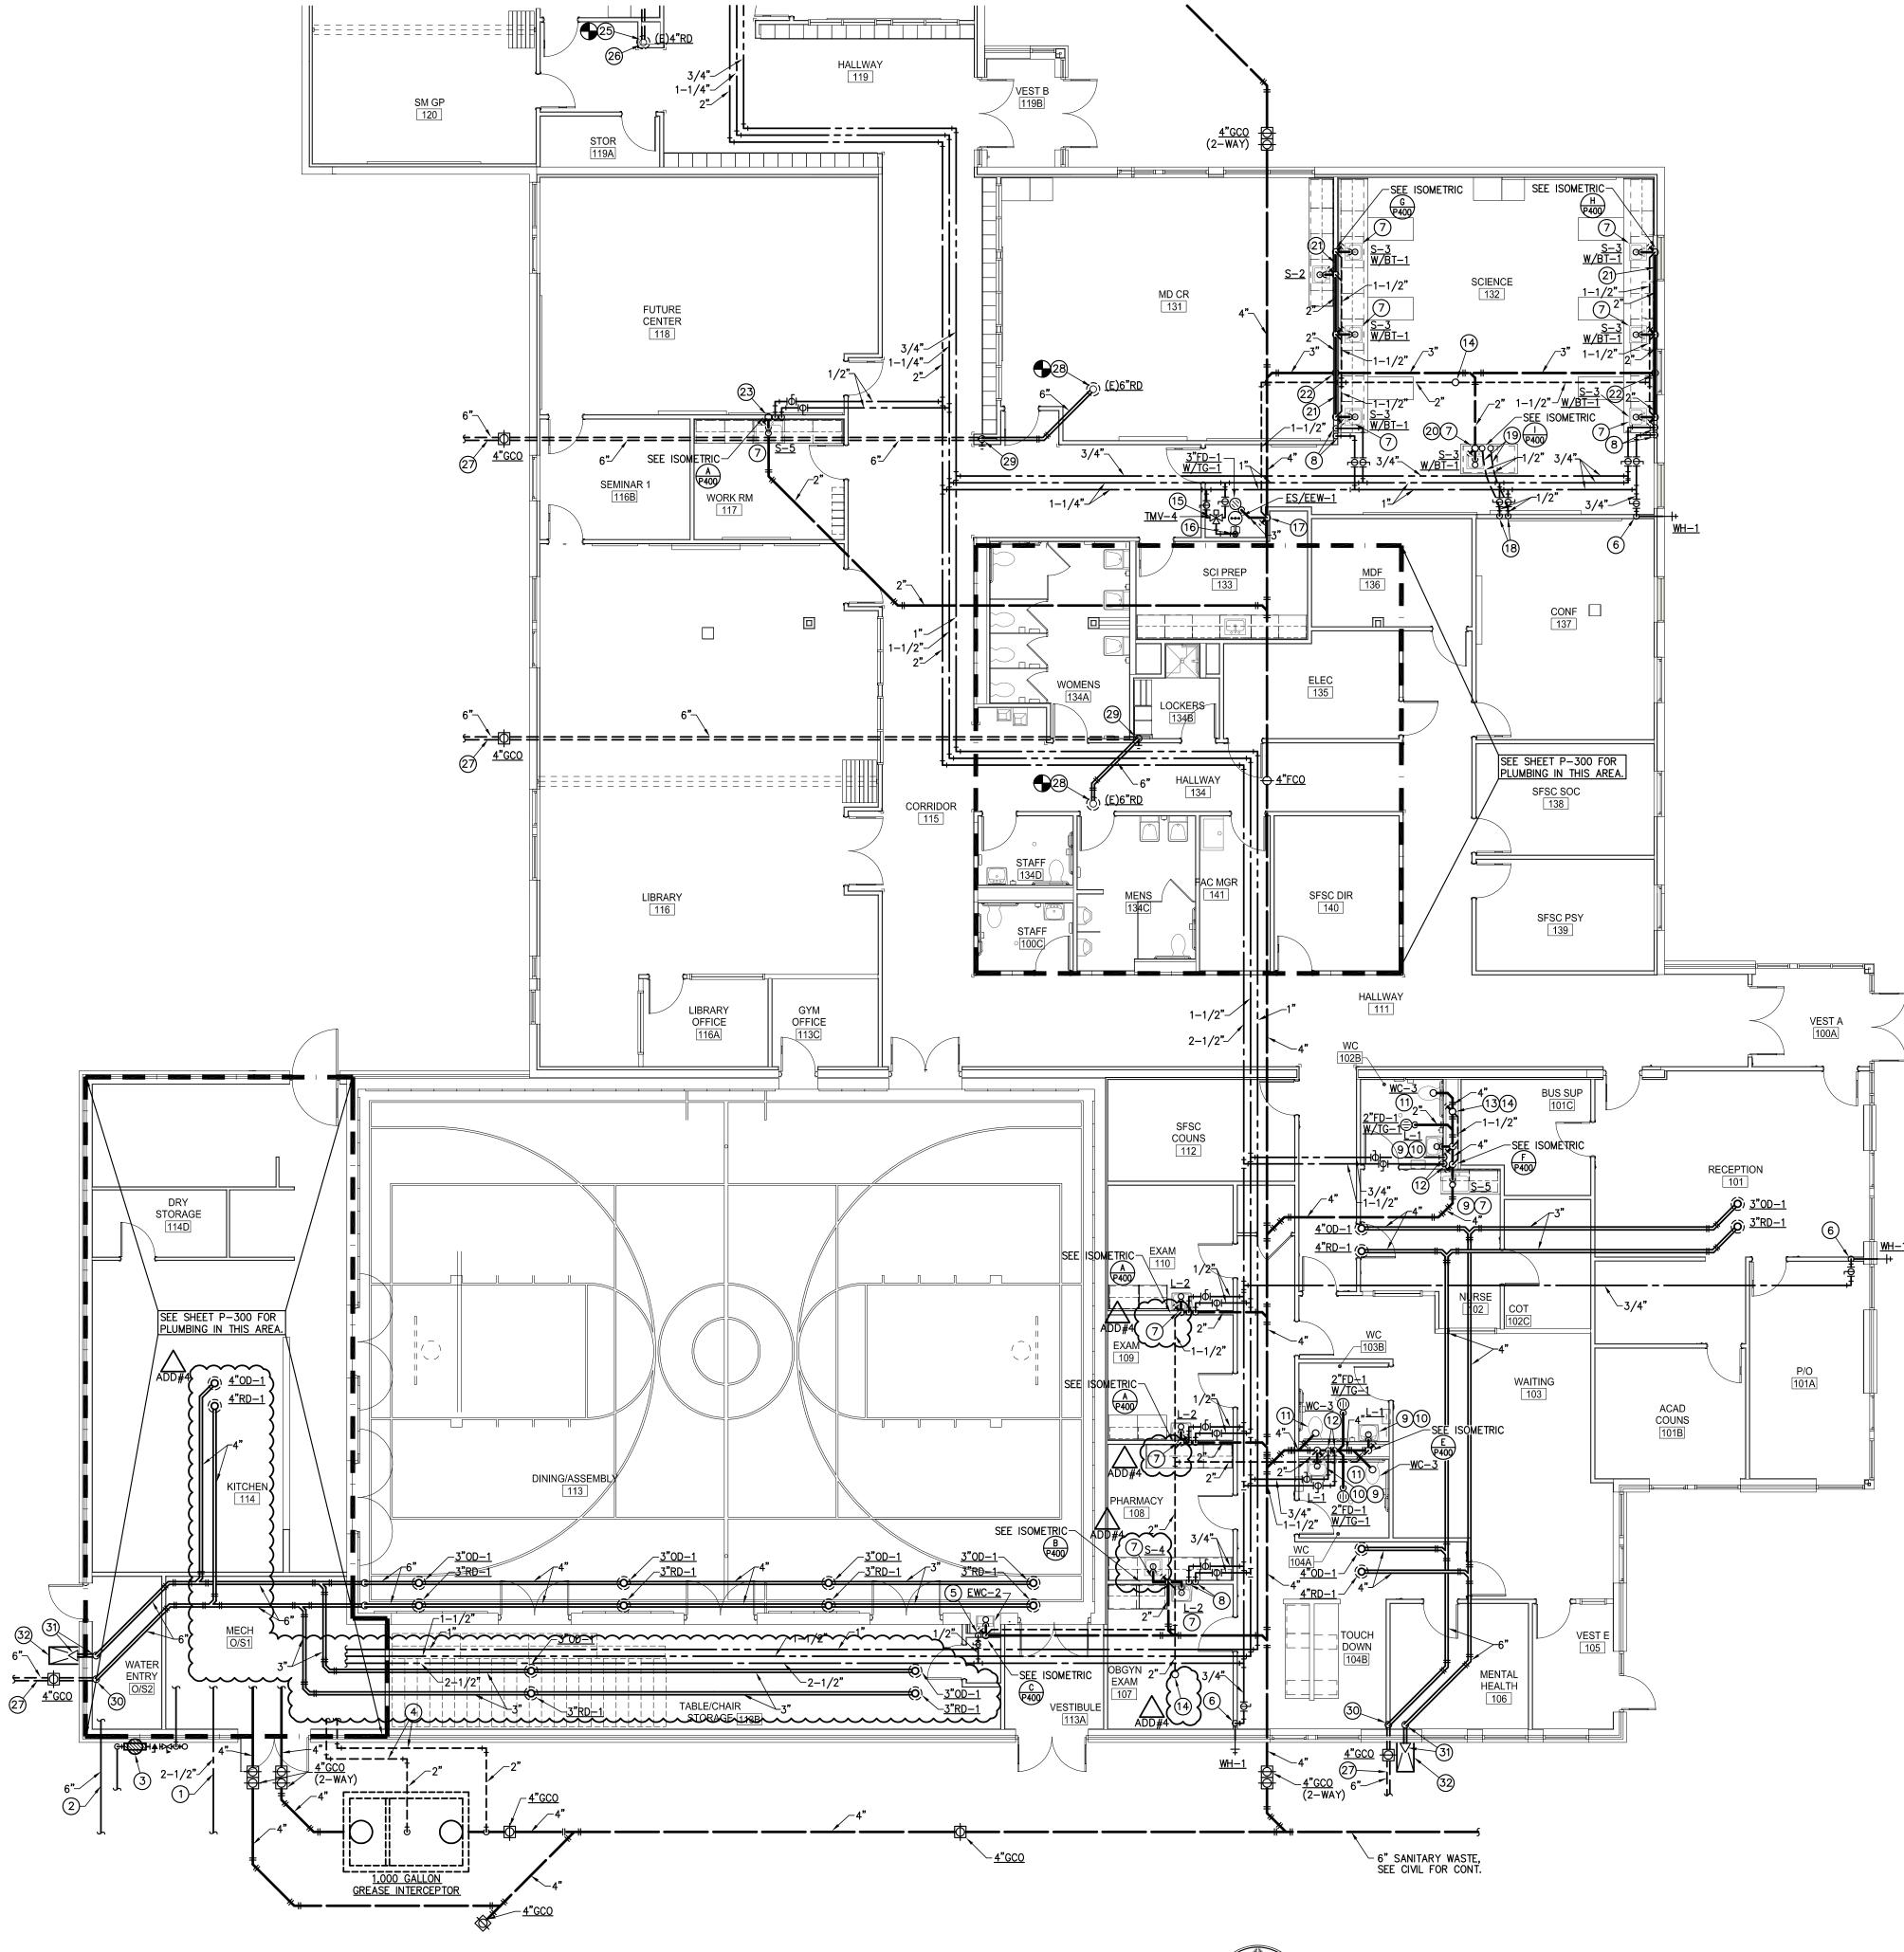

# SOUTH WING PLUMBING PLAN SCALE: 1/8"=1'-0"

### PLUMBING KEYNOTES:

1) 2-1/2" DOMESTIC WATER SERVICE TO 2" WATER METER, SEE CIVIL PLANS FOR CONTUATION AND METER LOCATION.

(2) 6" FIRE SERVICE, SEE CIVIL PLANS FOR CONT.

(3) GAS METER/SERVICE.

(4) (2) 2" VENT LINES TO GREASE INTERCEPTOR. (5) 2" W. DN., 1–1/2" V. RISE, 1/2" CW TO ELECTRIC WATER COOLER.

6 3/4" CW DOWN TO WALL HYDRANT.

7) 2" W. DN., 1-1/2" V. RISE, 1/2" CW & 1/2" HW TO LAVATORY/SINK.

(8) 3/4" CW & 3/4" HW DOWN IN WALL AND OFFSET TO FIXTURES.

(9) 1/2" CW & 1/2" HW TO THERMOSTATIC MIXING VALVE TMV-1 UNDER SINK/LAV. (10) 2" W. DN., 2" V. RISE, 1/2" CW & 1/2" HW TO LAVATORY.

(11) 4" WASTE & 1" CW TO WATER CLOSET.

12 1-1/2" CW & 3/4" HW DOWN IN WALL AND OFFSET TO FIXTURES.

(13) 2" VENT RISE.

(14) 2" VENT RISE TO 3" VTR. (15) 1-1/4" CW & 1-1/4" HW TO THERMOSTATIC MIXING VALVE TMV-4.

(16) 1-1/4" TW DOWN TO EMERGENCY SHOWER/EYEWASH.

(17) 1-1/2" VENT RISE.

(18) 1/2" CW & 1/2" HW DOWN IN WALL AND OFFSET UNDERGROUND TO SINK.

(19) LINES RUNNING UNDERGROUNG. 20 PROVIDE AIR ADMITTANCE VALVE.

(21) WASTE LINE RUNNING IN WALL ABOVE FLOOR SLAB.

(22) WASTE LINE DOWN AND OFFSET UNDERGROUND.

(23) 1-1/2" VENT RISE TO 3" VTR.

(24) 3" W. DN., 1-1/2" V. RISE, 1/2" CW & 1/2" HW TO MOP SINK.

(25) CONNECT EXISTING 4" ROOF DRAIN TO NEW 4" RWL. (26) 4" RWL DOWN IN WALL/CHASE W/ 4" CLEANOUT.

(27) 6" STORM DRAIN LINE, SEE CIVIL PLANS FOR CONTINUATION.

(28) CONNECT EXISTING 6" ROOF DRAIN TO NEW 6" RWL.

(29) 6" RWL DOWN IN WALL/CHASE W/ 4" CLEANOUT.

(30) 6" RWL DOWN ON WALL W/ 4" CLEANOUT.

(31) 6" OVERFLOW DOWN AND DISCHARGE 18" ABOVE GRADE W/ DOWNSPOUT NOZZLE.


800.0 MBH 399.0 MBH 399.0 MBH 399.0 MBH 600.0 MBH 480.0 MBH 400.0 MBH

4,517.0 MBH INPUT @ S.L. (14" W.C. GAS), M.C. TO COORDINATE WITH XCEL.

32) DISCHARGE OVERFLOW TO SPLASH BLOCK.

NEW GAS LOAD SCHEDULE

<u>APPLIANCE</u> (N) GAS WATER HEATER GWH-1 (N) BOILER B-1 (N) BOILER B-2 (N) BOILER B-2
(N) BOILER B-3
(N) ROOF TOP UNIT RTU-1
(N) ROOF TOP UNIT RTU-2
(N) ROOF TOP UNIT RTU-3 (N) MAKE-UP AIR UNIT MAU-1 (N) KITCHEN EQUIPMENT

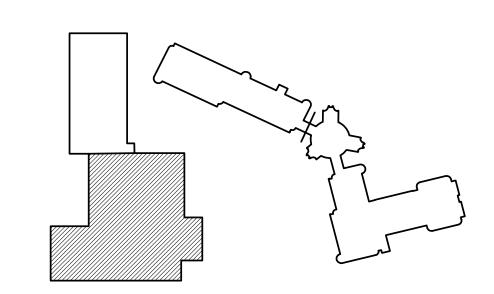

ADD#	07.24.14	BID ADDEN	IDUM #4		OZ	KY	
3	06.25.14	FOR CONS	TRUCTION		OZ	KY	
2	04.11.14	50% CONS	TRUCTION DOCUMENTS		OZ	KY	
1	01.10.14	100% SCHE	EMATIC DESIGN / DESIGN DEVELOPM	1ENT	OZ	KY	
NO.	DATE	DESCRIPTI	ON OF REVISION		AUTHORITY	MADE	APPR'D
				R PUBLIC SOMENT OF FACILITY MANASCHOOL NO. 982			VER , CO
			FLORE	ENCE CRITTI	=NITON		

FLORENCE CRITTENTON 113266.00 ZUNI STREET DENVER, COLORADO

DENVER PUBLIC SCHOOLS

DEPARTMENT OF
FACILITY MANAGEMENT FJG

KED BY: TRH

SOUTH WING PLUMBING June 25, 2014 1/8" = 1'-0" 3003 Larimer Street Denver, CO 80205 phone 303.861.5704


ARCHITECTURE www.ozarch.com


DWG NO.







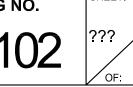

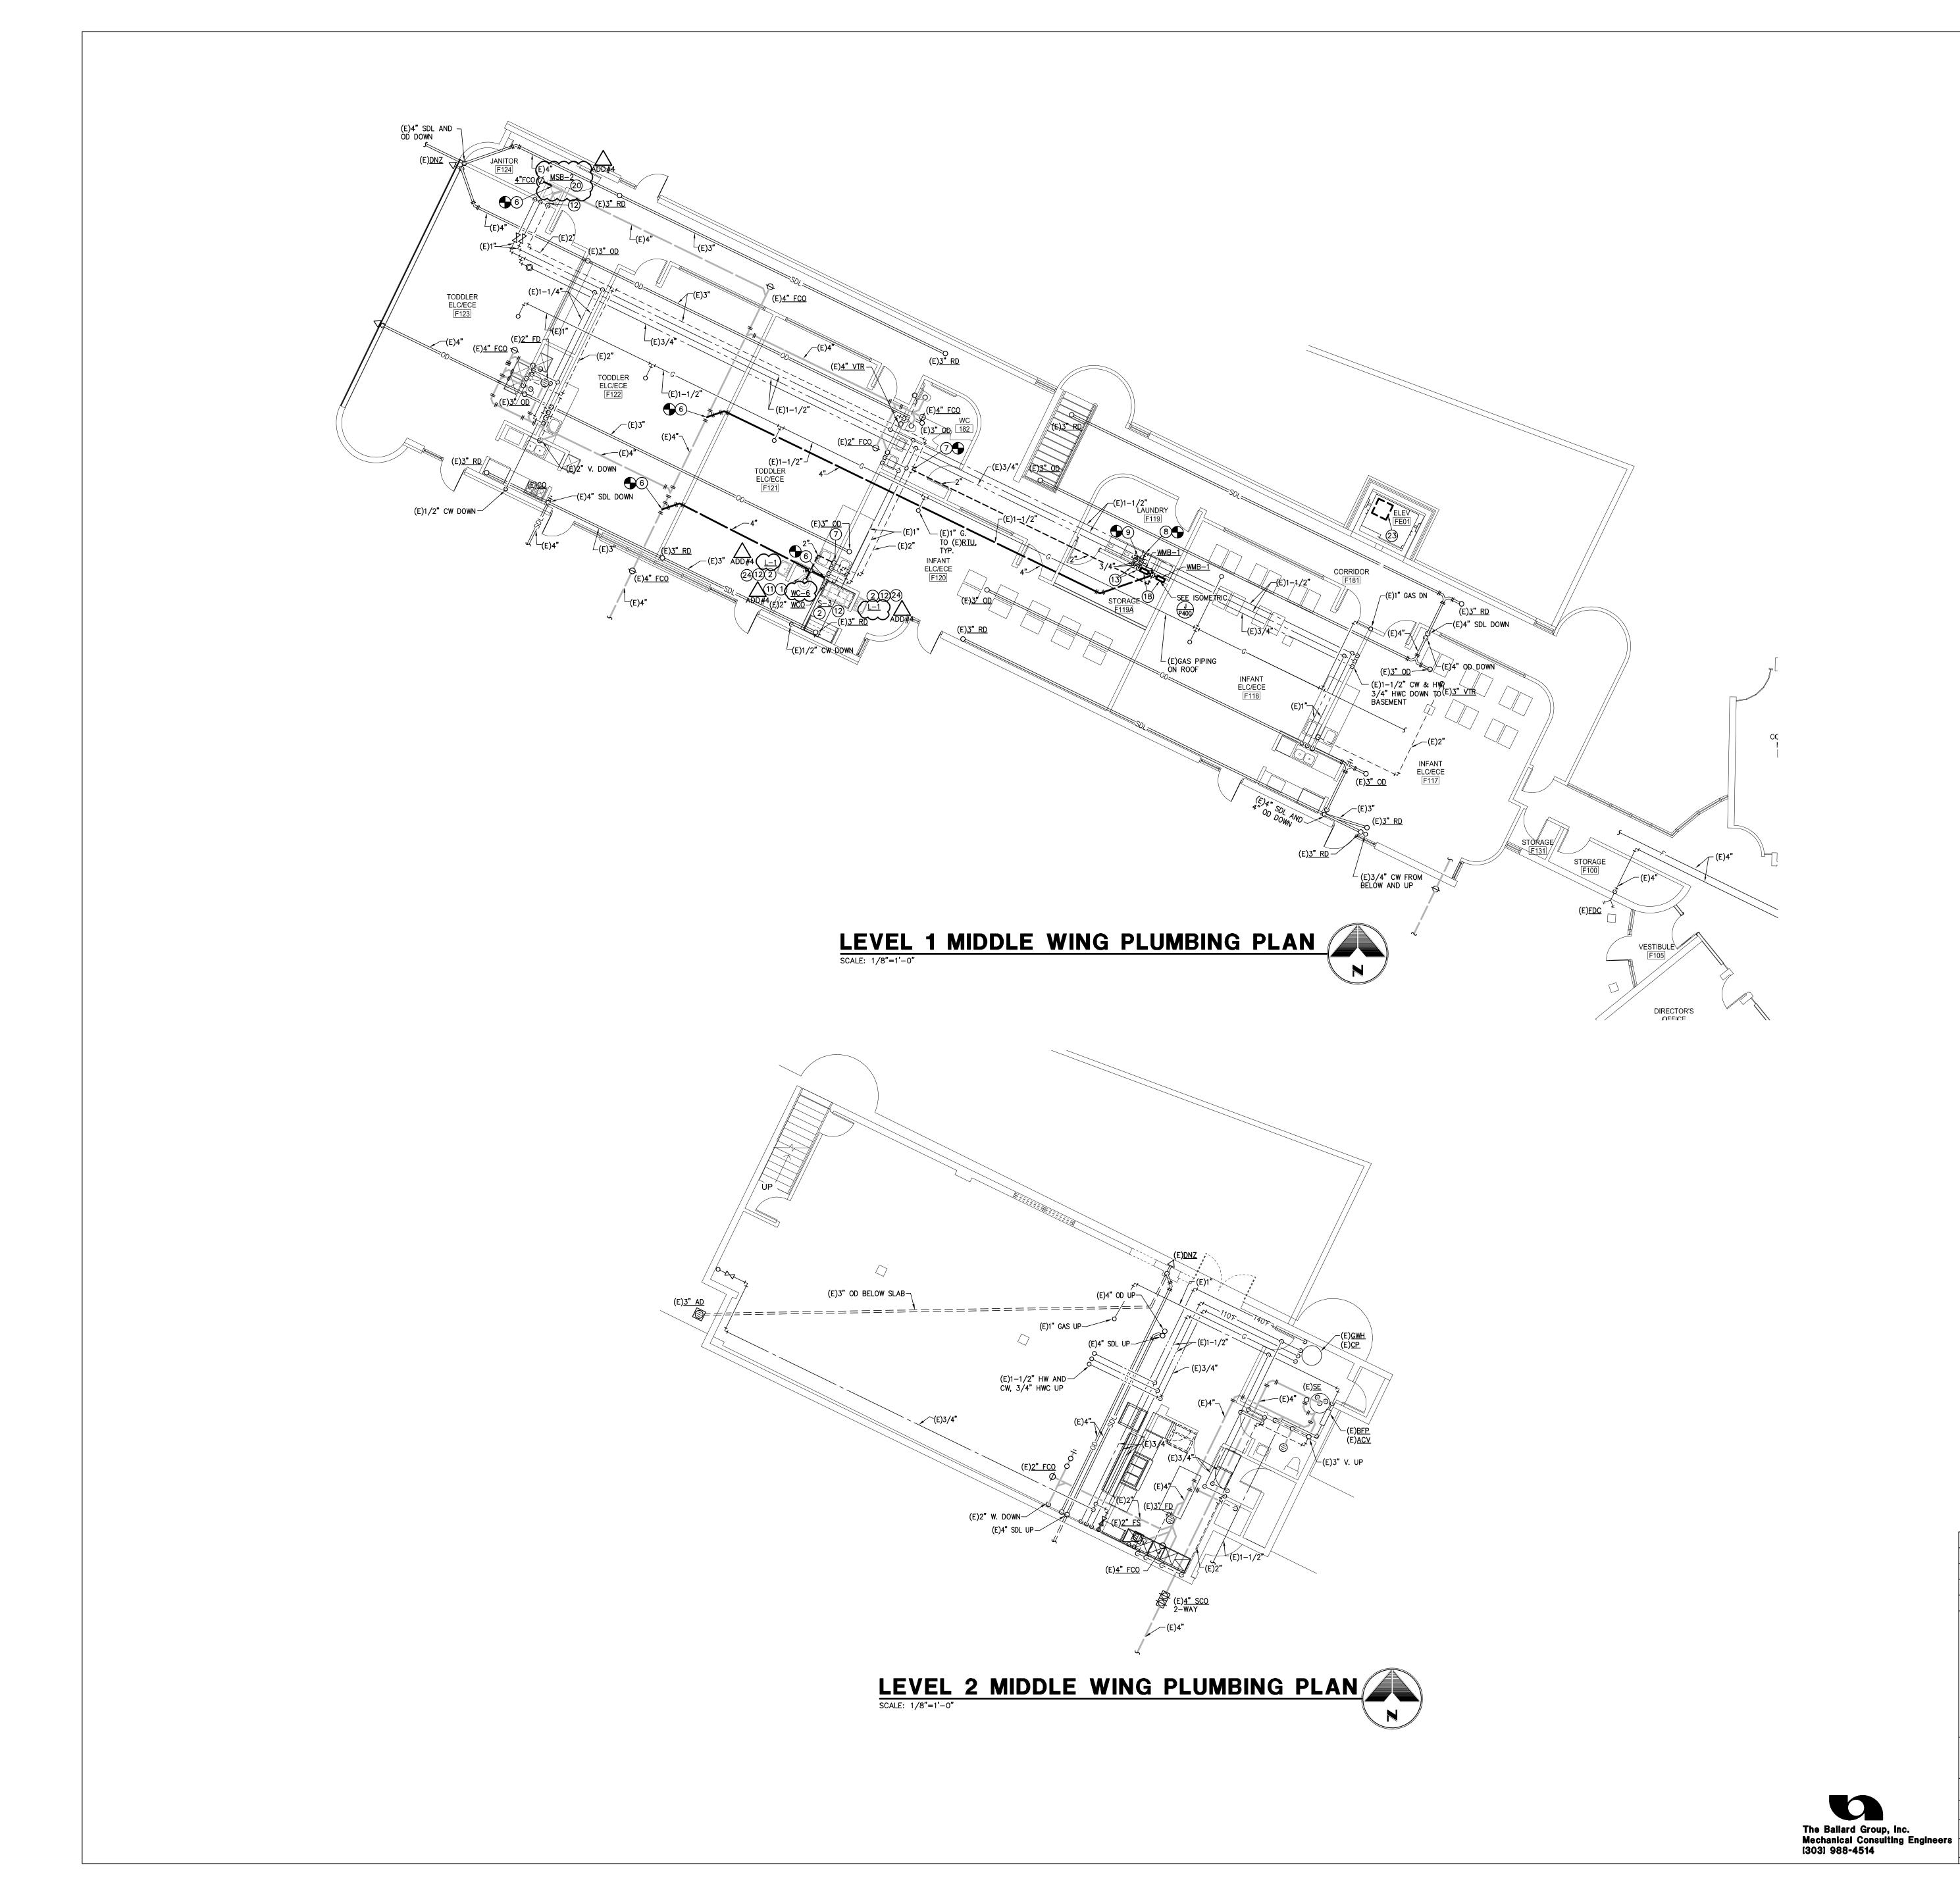

## PLUMBING KEYNOTES:

1 4" WASTE & 1/2" CW TO WATER CLOSET.

2) 2" W. DN., 1-1/2" V. RISE, 1/2" CW & 1/2" HW TO LAVATORY/SINK.

3 2" W. DN., 2" V. RISE, 1/2" CW & 1/2" HW TO LAVATORY. 4 2" VENT RISE.

(5) 2" VENT RISE TO 3" VTR.

(6) CONNECT NEW WASTE LINE TO EXIST. WASTE LINE.

(7) CONNECT NEW VENT LINE TO EXIST. VENT LINE. (8) CONNECT NEW CW LINE TO EXIST. CW LINE.

9 CONNECT NEW HW LINE TO EXIST. HW LINE.

(10) CONNECT NEW HWC LINE TO EXIST. HWC LINE.

(11) EXTEND 1/2" CW IN WALL TO WATER CLOSET.

(12) CONNECT NEW FIXTURE TO EXIST. PLUMBING IN WALL. (13) 3/4" CW & 3/4" HW DOWN IN WALL AND OFFSET TO FIXTURES.

(14) 1-1/4" CW & 3/4" HW DOWN IN WALL AND OFFSET TO FIXTURES. 15) PROVIDE AIR ADMITTANCE VALVE.

(16) 1" CW DOWN IN WALL AND OFFSET TO FIXTURES.

(17) PROVIDE BALANCING VALVE SET AT 1.0 GPM.


(18) 4" W. DN., 2" V. RISE, 1/2" CW & 1/2" HW TO WASHER BOX.

(19) PROVIDE BALANCING VALVE SET AT 1.0 GPM. (20) 3" W. DN., 1-1/2" V. RISE, 1/2" CW & 1/2" HW TO MOP SINK.

(21) CONNECT NEW CW & HW LINES TO EXIST. CW & HW LINES.

22) 4" RISE FROM UP FROM 2ND FLOOR, CONNECT TO EXIST. 4" VTR. 23) 24" X 24" X 36" ELEVATOR SUMP BY G.C.

24) 1/2" CW & 1/2" HW TO THERMOSTATIC MIXING VALVE UNDER LAV/SINK.

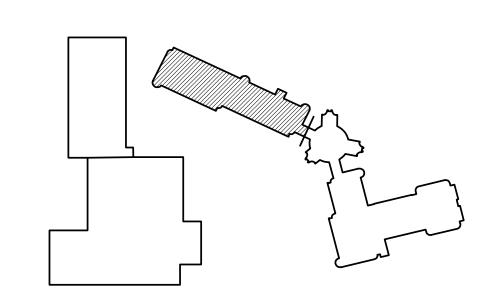

ADD#4	07.24.14	BID ADDEN	 DUM #4		OZ	KY	
3	06.25.14	FOR CONS	TRUCTION		OZ	KY	
2	04.11.14	50% CONS	FRUCTION DOCUMENTS		OZ	KY	
1	01.10.14	100% SCHE	MATIC DESIGN / DESIGN DEVELOPN	OZ	KY		
NO.	DATE	DESCRIPTI	ON OF REVISION	AUTHORITY	MADE	APPR'D	
				R PUBLIC S MENT OF FACILITY MA		LS	
			SCHOOL DISTRICT NO. 1	SCHOOL NO. 982	SITE NO.	DEN'	VER , CO
			FLOR	ENCE CRIT	TENTON	1	
				113266.00 ZUNI STREET DENVER, COLORAI	DO		

DENVER PUBLIC SCHOOLS


DEPARTMENT OF
FACILITY MANAGEMENT

June 25, 2014

1/8" = 1'-0"

PLANS 3003 Larimer Street
Denver, CO 80205
phone 303.861.5704
www.ozarch.com

MIDDLE WING PLUMBING

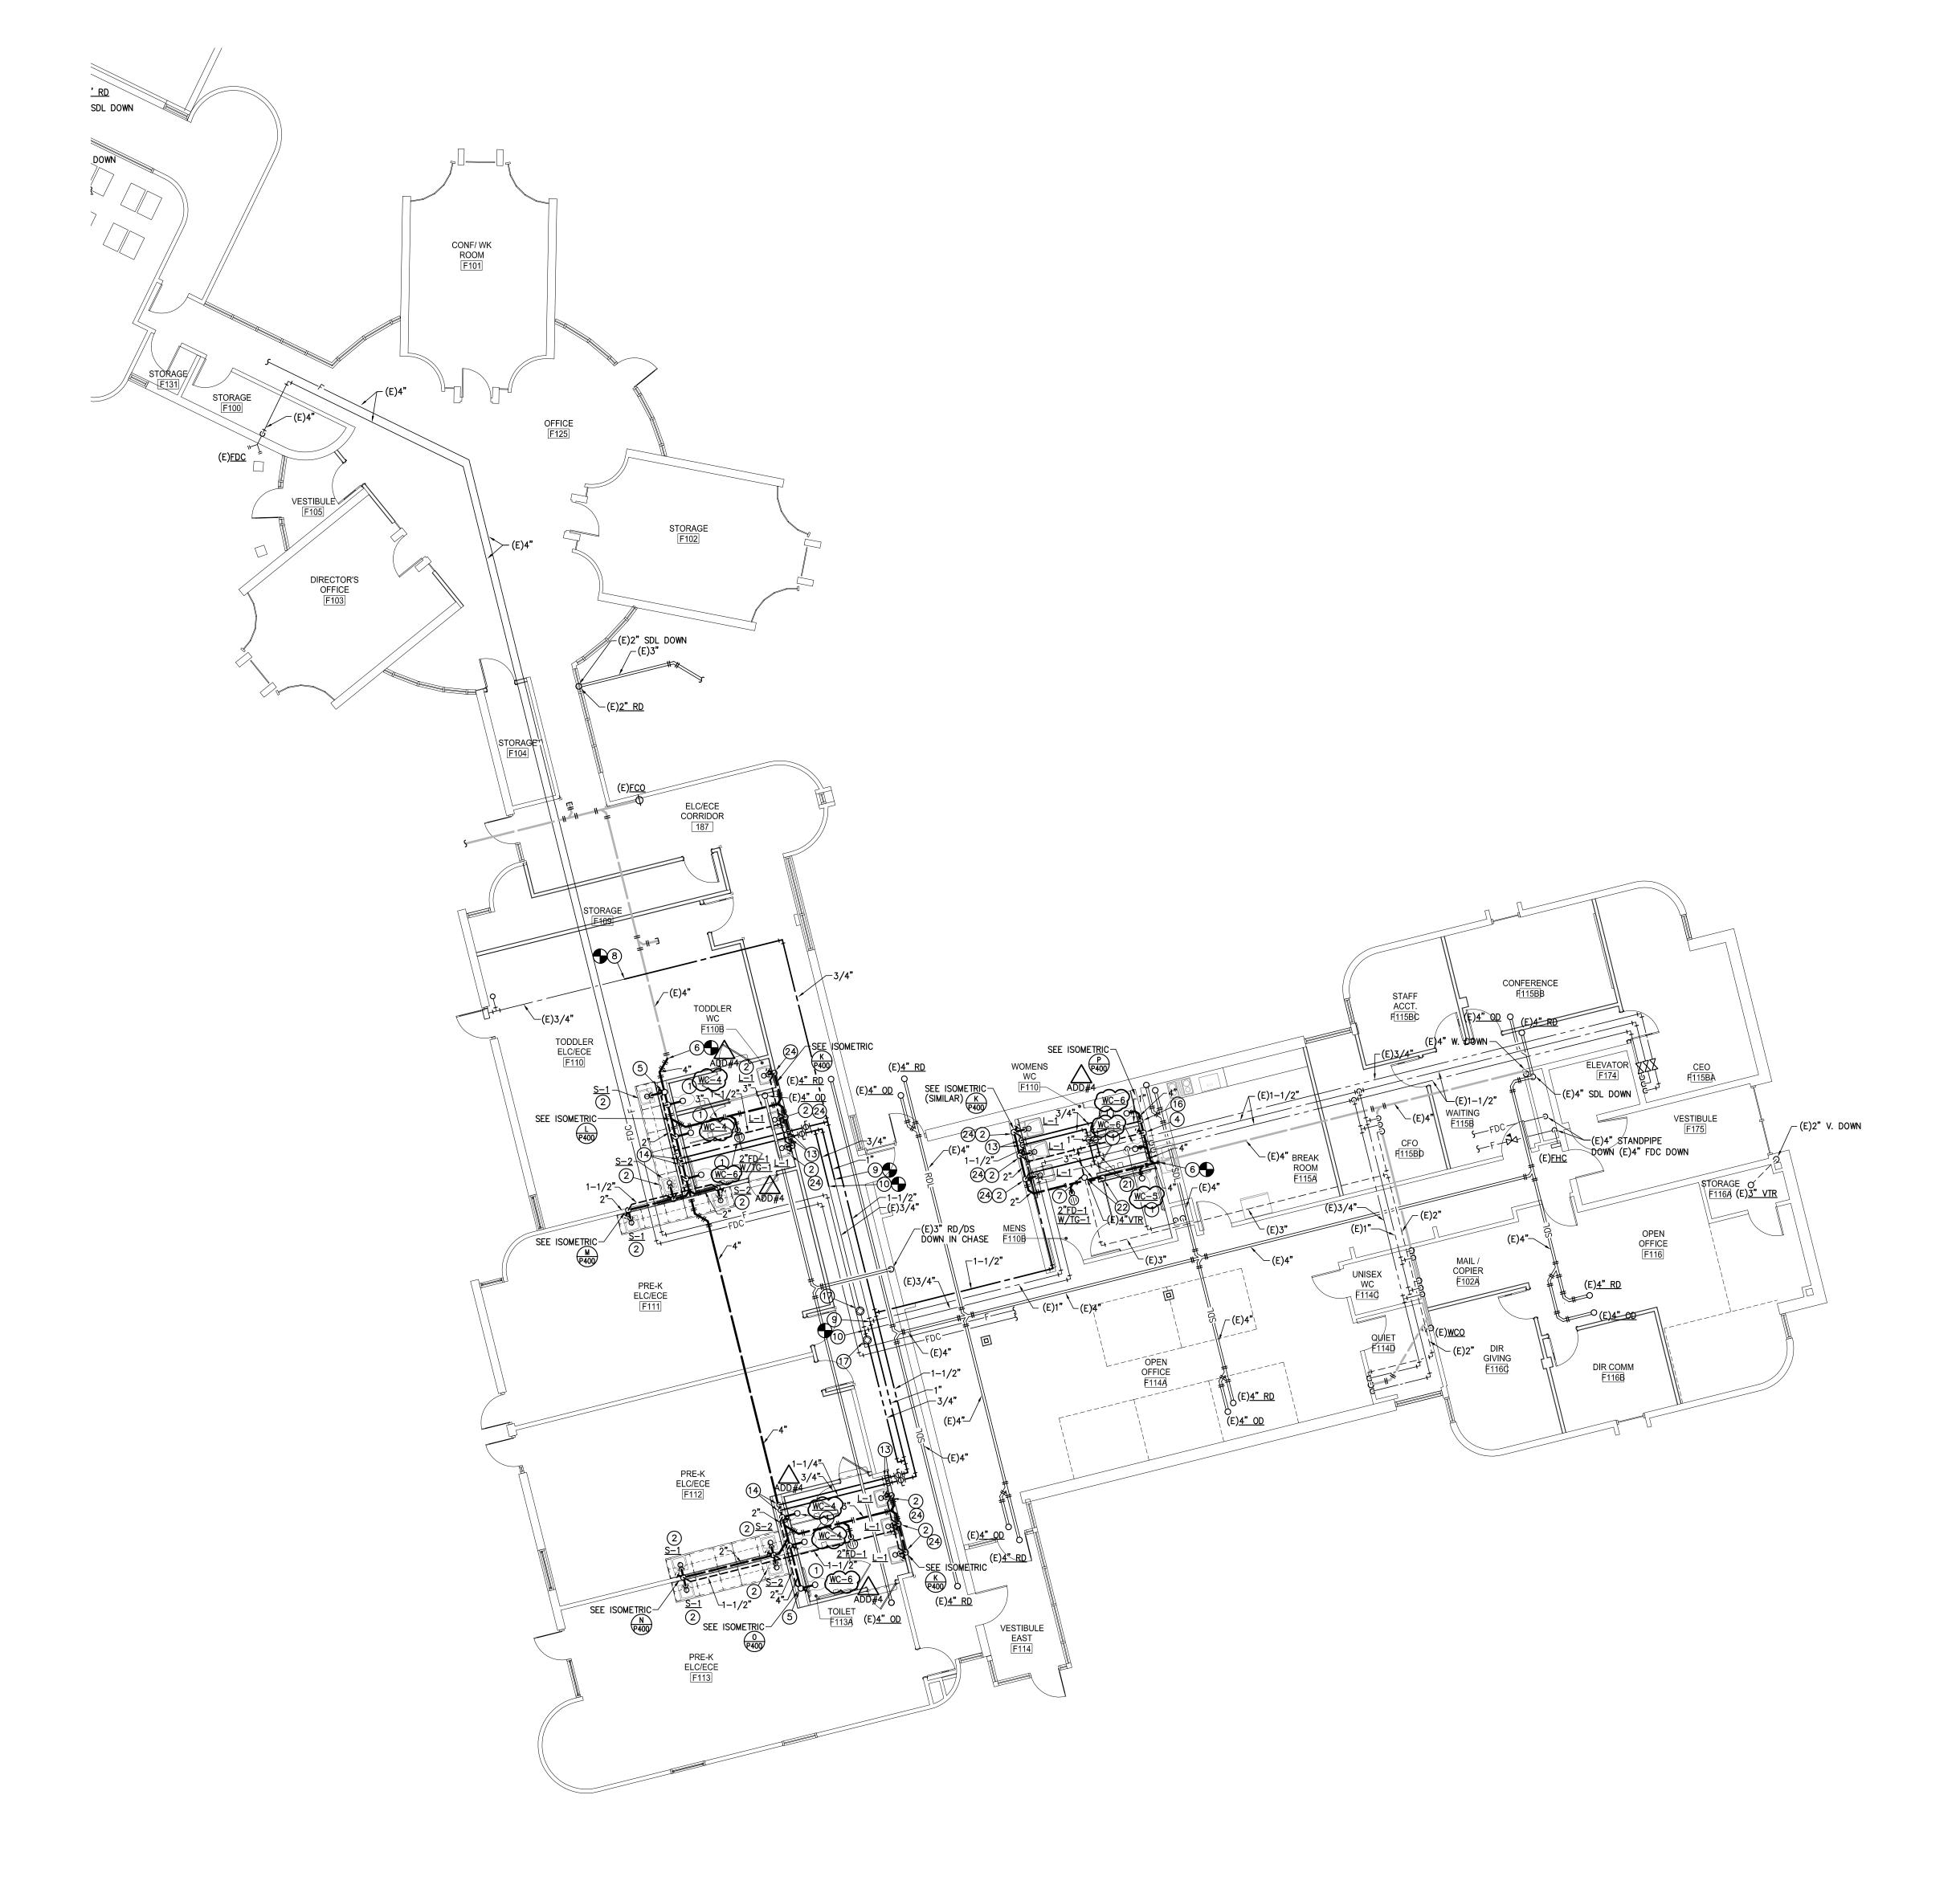



## PLUMBING KEYNOTES:

1) 4" WASTE & 1/2" CW TO WATER CLOSET.

2) 2" W. DN., 1-1/2" V. RISE, 1/2" CW & 1/2" HW TO LAVATORY/SINK. 3 2" W. DN., 2" V. RISE, 1/2" CW & 1/2" HW TO LAVATORY.

4 2" VENT RISE.

5) 2" VENT RISE TO 3" VTR.

(6) CONNECT NEW WASTE LINE TO EXIST. WASTE LINE.

7 CONNECT NEW VENT LINE TO EXIST. VENT LINE.

8 CONNECT NEW CW LINE TO EXIST. CW LINE. 9 CONNECT NEW HW LINE TO EXIST. HW LINE.

(10) CONNECT NEW HWC LINE TO EXIST. HWC LINE.

1) EXTEND 1/2" CW IN WALL TO WATER CLOSET. (12) CONNECT NEW FIXTURE TO EXIST. PLUMBING IN WALL.

(13) 3/4" CW & 3/4" HW DOWN IN WALL AND OFFSET TO FIXTURES.

14) 1-1/4" CW & 3/4" HW DOWN IN WALL AND OFFSET TO FIXTURES.

15) PROVIDE AIR ADMITTANCE VALVE.

16) 1" CW DOWN IN WALL AND OFFSET TO FIXTURES.

(17) PROVIDE BALANCING VALVE SET AT 1.0 GPM.

(18) 4" W. DN., 2" V. RISE, 1/2" CW & 1/2" HW TO WASHER BOX. (19) PROVIDE BALANCING VALVE SET AT 1.0 GPM.


② 3" W. DN., 1-1/2" V. RISE, 1/2" CW & 1/2" HW TO MOP SINK.

(21) CONNECT NEW CW & HW LINES TO EXIST. CW & HW LINES.

(22) 4" RISE FROM UP FROM 2ND FLOOR, CONNECT TO EXIST. 4" VTR.

23 24" X 24" X 36" ELEVATOR SUMP BY G.C.

24) 1/2" CW & 1/2" HW TO THERMOSTATIC MIXING VALVE UNDER LAV/SINK.

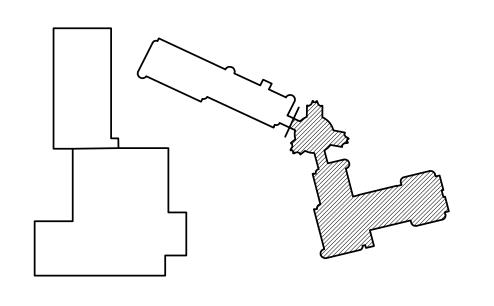

3   06.25.14   FOR CONSTRUCTION   OZ   KY     2   04.11.14   50% CONSTRUCTION DOCUMENTS   OZ   KY     1   01.10.14   100% SCHEMATIC DESIGN / DESIGN DEVELOPMENT   OZ   KY	C
3   06.25.14   FOR CONSTRUCTION   OZ   KY     2   04.11.14   50% CONSTRUCTION DOCUMENTS   OZ   KY	MADE APPR'
3 06.25.14 FOR CONSTRUCTION OZ KY	KY
700#7	KY
ADD#4   STILL TO THE STILL TO T	KY
ADD#4 07.24.14 BID ADDENDUM #4 OZ KY	KY

DENVER PUBLIC SCHOOLS DEPARTMENT OF FACILITY MANAGEMENT

SCHOOL DISTRICT NO. 1 SCHOOL NO. 982 SITE NO. FLORENCE CRITTENTON

113266.00
ZUNI STREET
DENVER, COLORADO

DENVER PUBLIC SCHOOLS

DEPARTMENT OF
FACILITY MANAGEMENT EAST WING PLUMBING PLAN FJG


KED BY: TRH

The Ballard Group, Inc.
Mechanical Consulting Engineers
(303) 988-4514


1/8" = 1'-0"

DENVER , CO




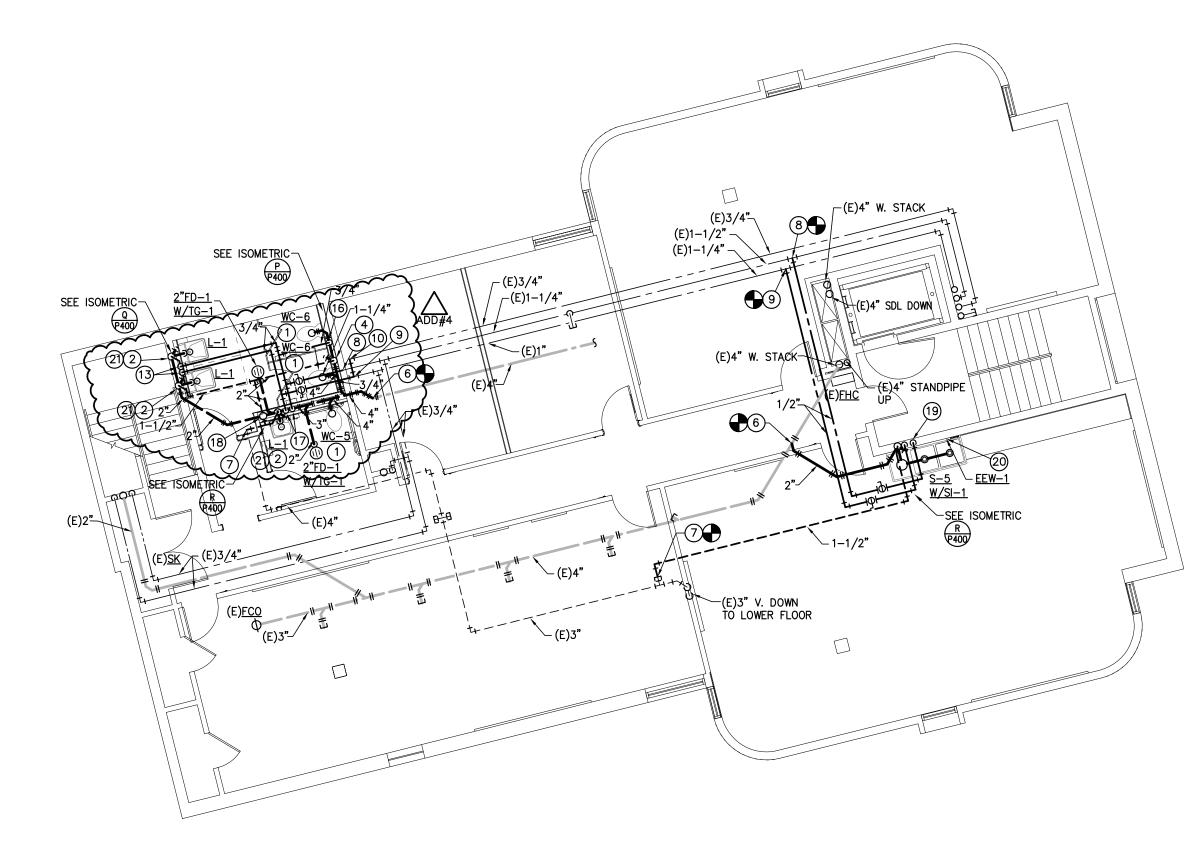



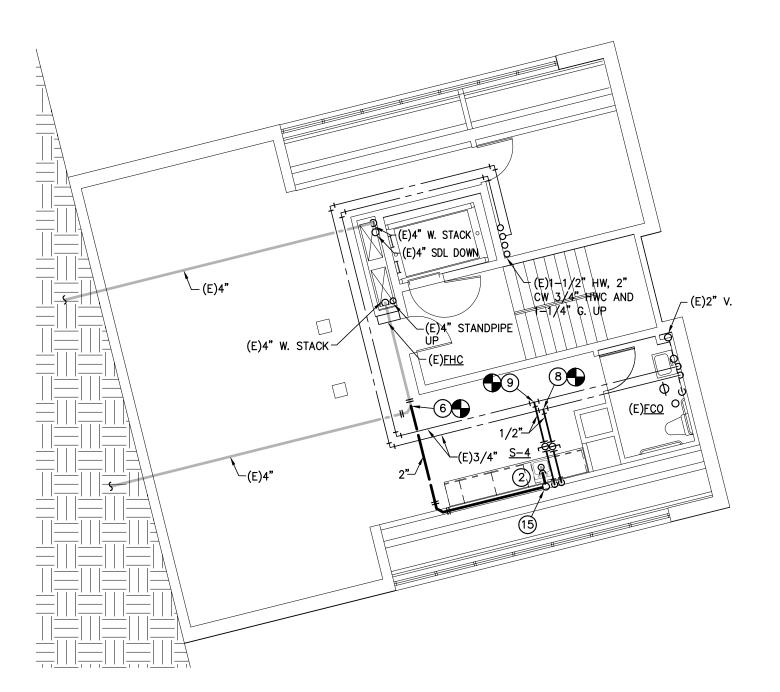



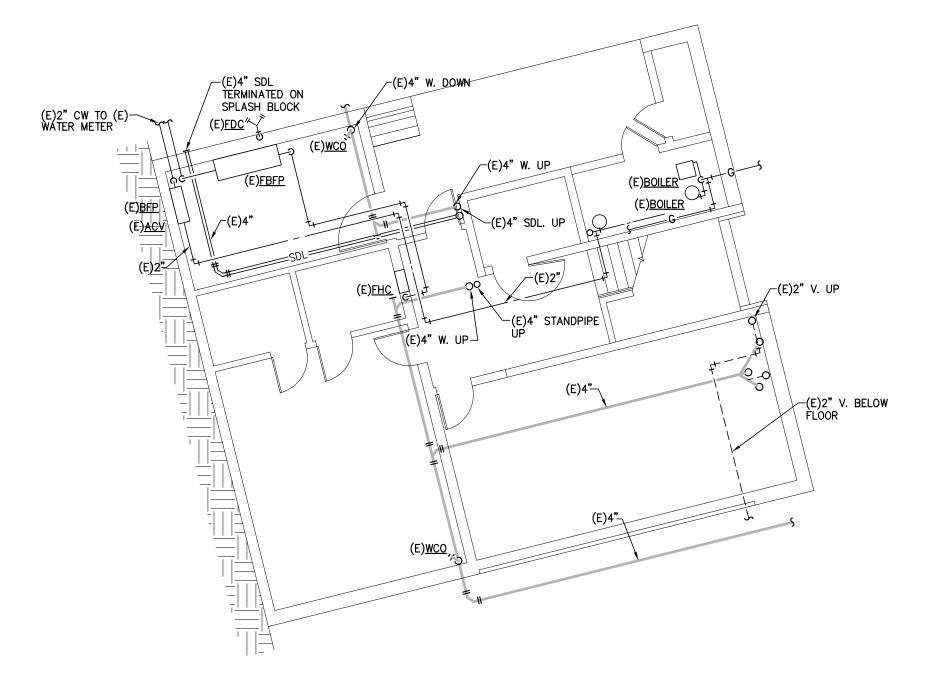

LEVEL 4 TOWER PLUMBING PLAN

SCALE: 1/8"=1'-0"



1) 4" WASTE & 1/2" CW TO WATER CLOSET.

2 2" W. DN., 1-1/2" V. RISE, 1/2" CW & 1/2" HW TO LAVATORY/SINK.

(3) 2" W. DN., 2" V. RISE, 1/2" CW & 1/2" HW TO LAVATORY.

4 2" VENT RISE.

5 2" VENT RISE TO 3" VTR.

(6) CONNECT NEW WASTE LINE TO EXIST. WASTE LINE. (7) CONNECT NEW VENT LINE TO EXIST. VENT LINE.

(8) CONNECT NEW CW LINE TO EXIST. CW LINE.

(9) CONNECT NEW HW LINE TO EXIST. HW LINE.

(10) CONNECT NEW HWC LINE TO EXIST. HWC LINE. (11) EXTEND 1/2" CW IN WALL TO WATER CLOSET.

(12) RECONNECT NEW FIXTURE TO EXIST. PLUMBING IN WALL.

(13) 3/4" CW & 3/4" HW DOWN IN WALL AND OFFSET TO FIXTURES.

(14) 1-1/4" CW & 3/4" HW DOWN IN WALL AND OFFSET TO FIXTURES. (15) PROVIDE AIR ADMITTANCE VALVE.

(16) 3/4" CW DOWN IN WALL AND OFFSET TO FIXTURES.


(17) 3/4" CW & 1/2" HW DOWN IN WALL AND OFFSET TO FIXTURES.

(18) 4" VENT RISER UP TO 1ST FLOOR. (19) 2" W. THRU SOLIDS INTERCEPTOR, 1-1/2" V. RISE, 1/2" CW & 1/2" HW TO ART SINK.

20) 1/2" CW & 1/2 HW TO EEW-1 THERMOSTATIC MIXING VALVE, 1/2" TW TO EEW-1 INLET.

21) 1/2" CW & 1/2 HW TO THERMOSTATIC MIXING VALVE TMV-1 UNDER SINK.

ADD#4

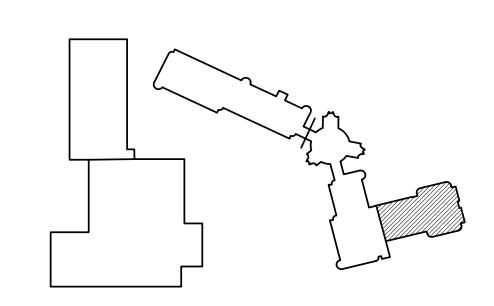

ADD#4	07.24.14	BID ADDEN	DUM #4		OZ	KY	
3	06.25.14	FOR CONS	TRUCTION		OZ	KY	
2	04.11.14	50% CONS	TRUCTION DOCUMENTS		OZ	KY	
1	01.10.14	100% SCHE	MATIC DESIGN / DESIGN DEVELOPM	MENT	OZ	KY	
NO.	DATE	DESCRIPTI	ON OF REVISION		AUTHORITY	MADE	APPR'D
				R PUBLIC S MENT OF FACILITY MAI		LS DEN	VER CO

FLORENCE CRITTENTON

113266.00
ZUNI STREET
DENVER, COLORADO

DENVER PUBLIC SCHOOLS

DEPARTMENT OF
FACILITY MANAGEMENT FJG


CKED BY: TRH

EAST WING TOWER
PLUMBING PLANS








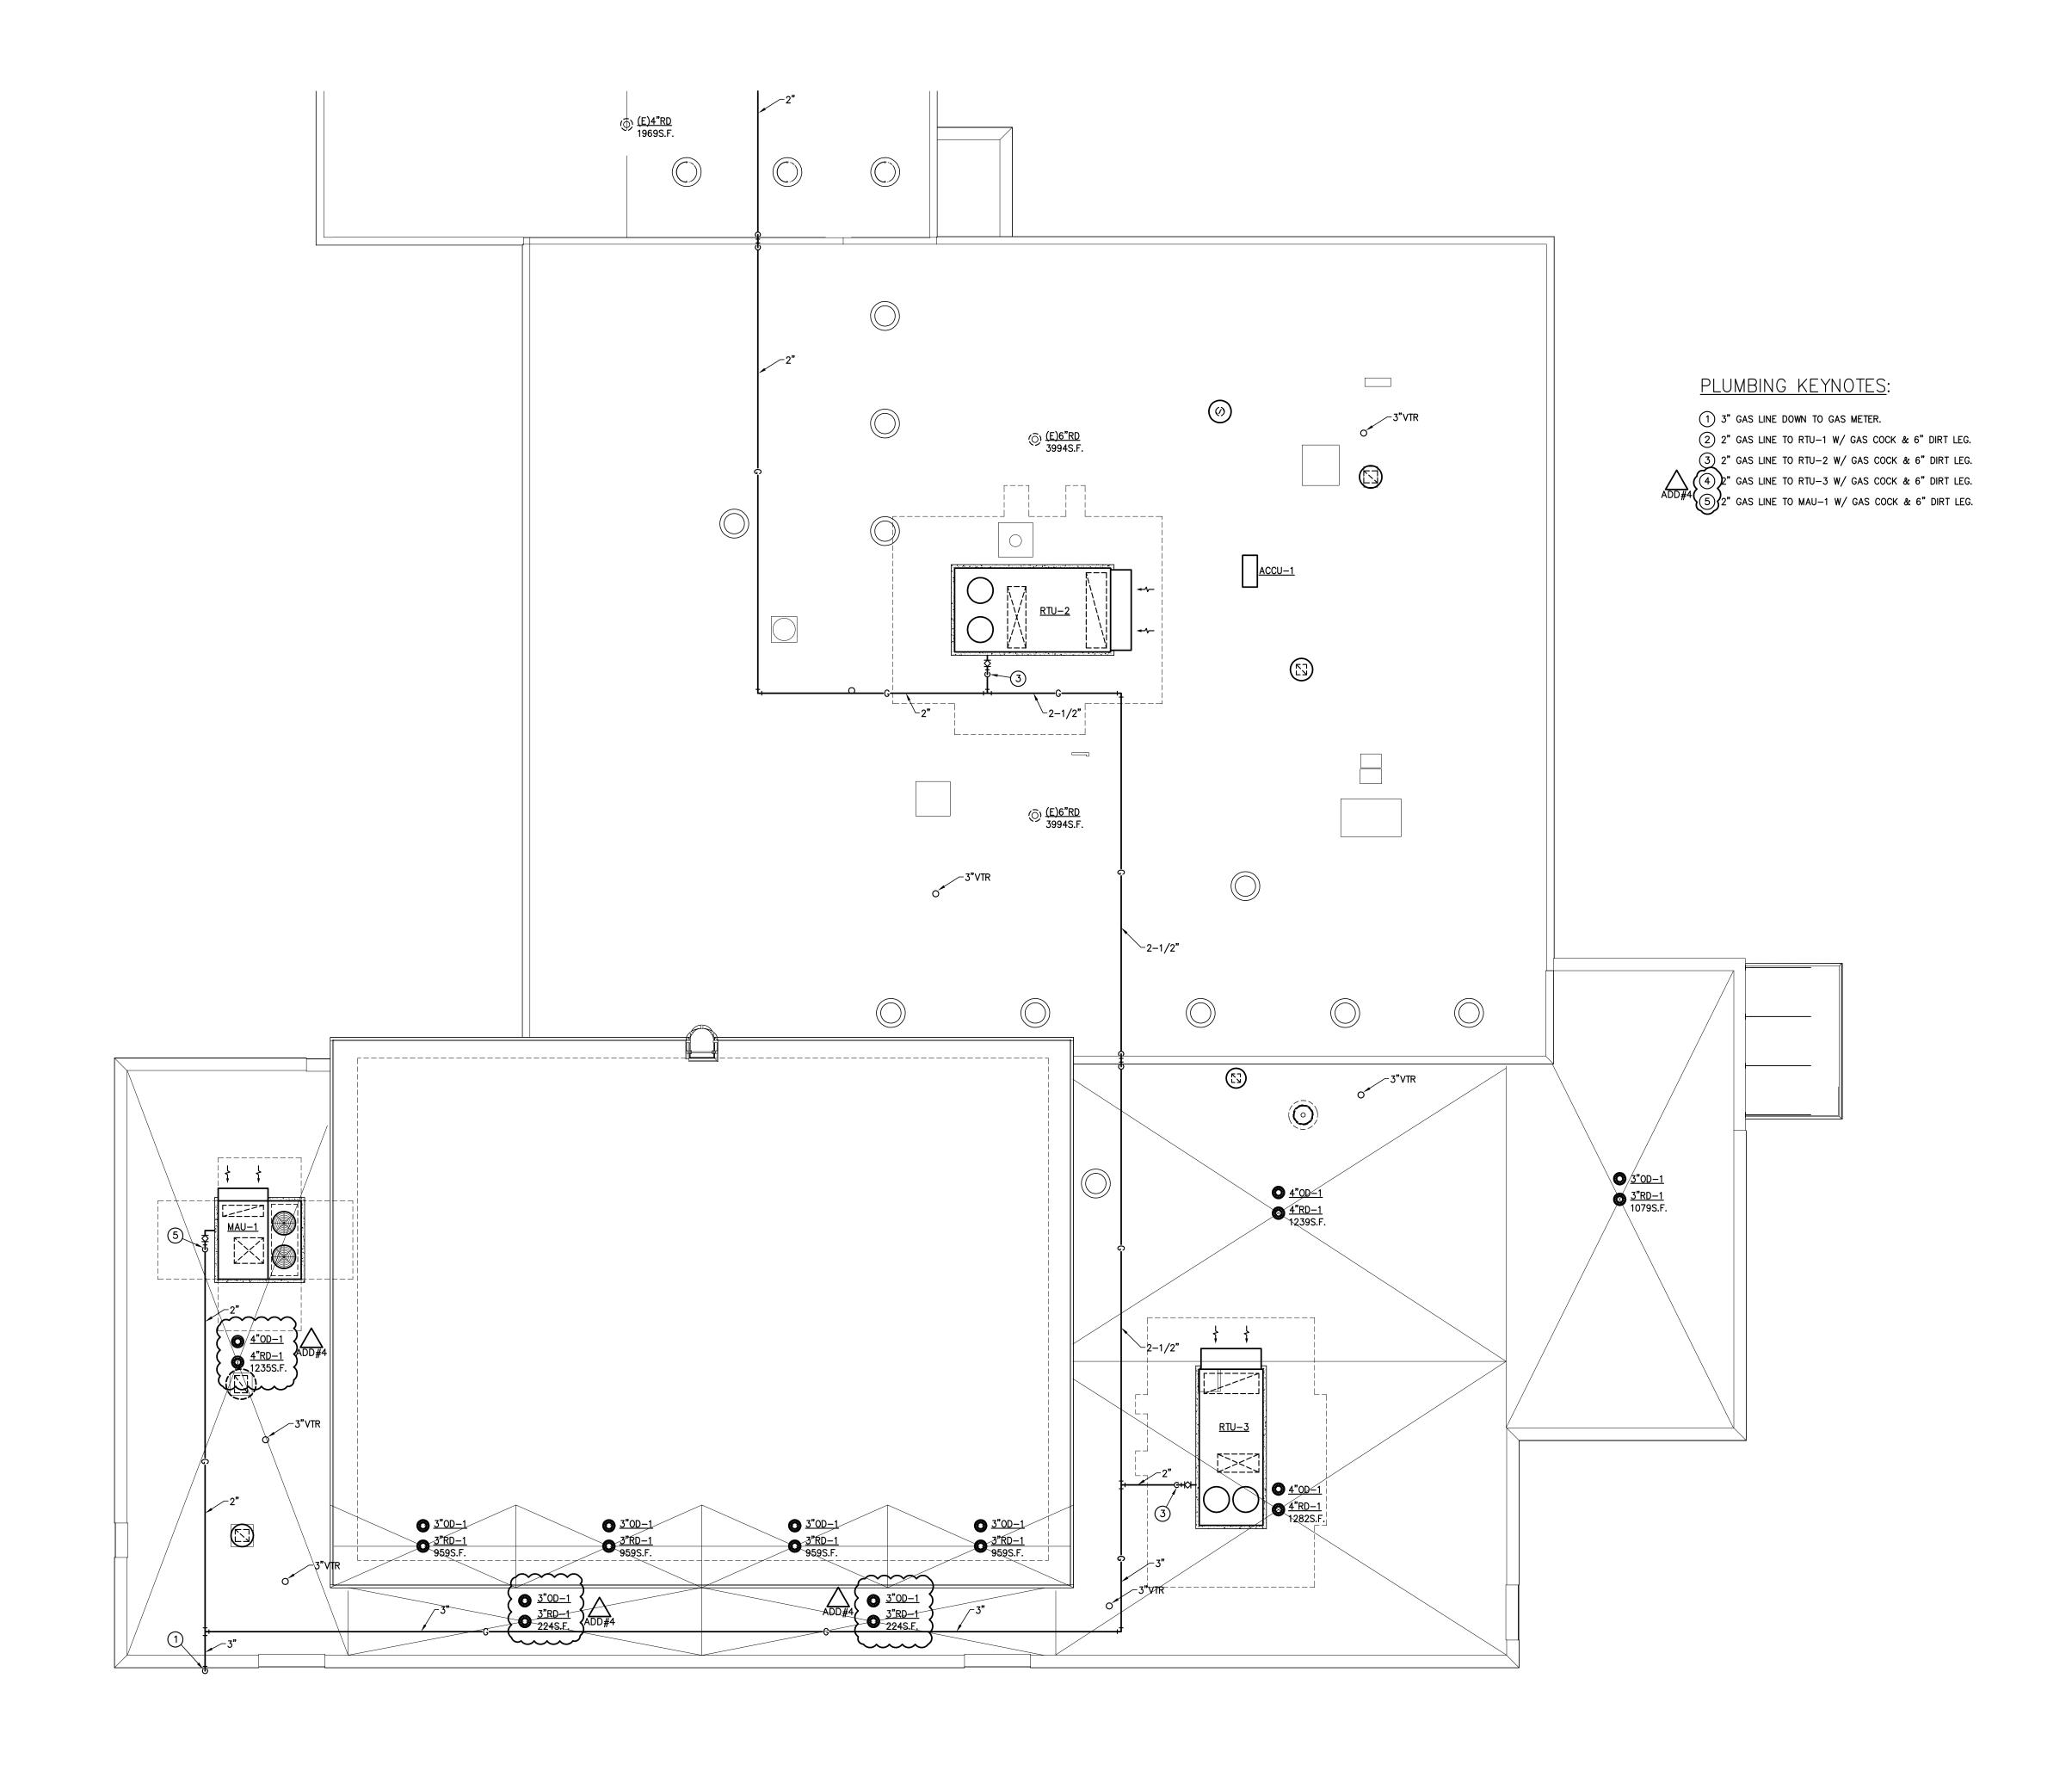





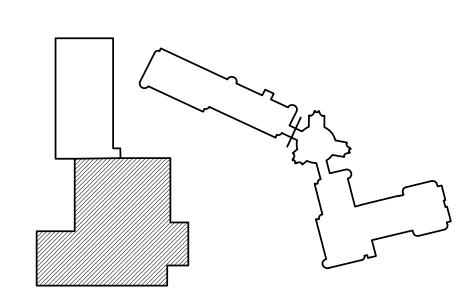

	ADD#4	07.24.14	BID ADDEN	DUM #4			OZ	KY		
	3	06.25.14	FOR CONS	TRUCTION			OZ	KY		
	2	04.11.14	50% CONS	TRUCTION DOCUMENTS			OZ	KY		_
	1	01.10.14	100% SCHE	MATIC DESIGN / DESIGN DE	EVELOPI	MENT	OZ	KY		1
	NO.	DATE	DESCRIPTI	ON OF REVISION			AUTHORITY	MADE	APPR'D	
	DENVER PUBLIC SCHOOLS  DEPARTMENT OF FACILITY MANAGEMENT									
	SCHOOL DISTRICT NO. 1 SCHOOL NO. 982 SI							DEN	VER, CO	
	FLORENCE CRITTE							1		
	113266.00 ZUNI STREET DENVER, COLORADO									-112
	DENVER PUBLIC SCHOOLS DEPARTMENT OF FACILITY MANAGEMENT  DESIGNED BY: FJG DRAWN BY: FJG CHECKED BY: TRH DATE: June 25, 2014 SCALE: 1/8" = 1'-0"  DESIGNED BY: FJG DRAWN BY							/1101 - P		
nc. g Engineers	DATE:			3003 Larin Denver, C phone 303 www.oza	O 8020 .861.57	05 704	DWG NO. P-112	- /		970-684/1

PLOI DAIE: July 24, 2014 @ 6:04pm FILE LOCATION: N:\13145\P112 THRU P113.dwg; LAYOUT NAME

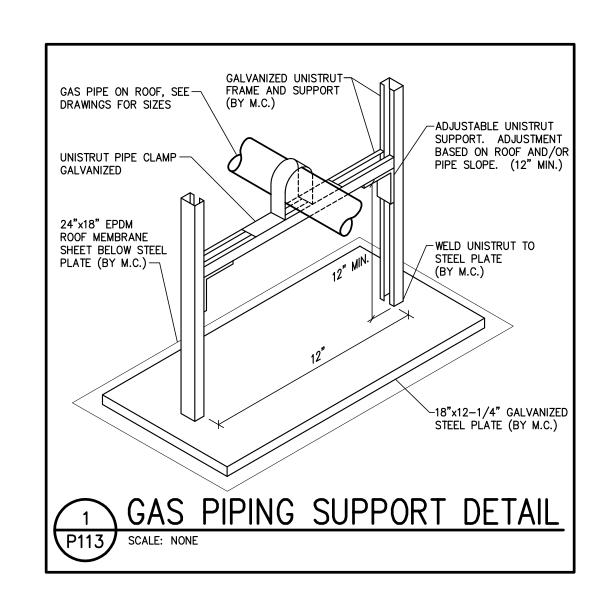


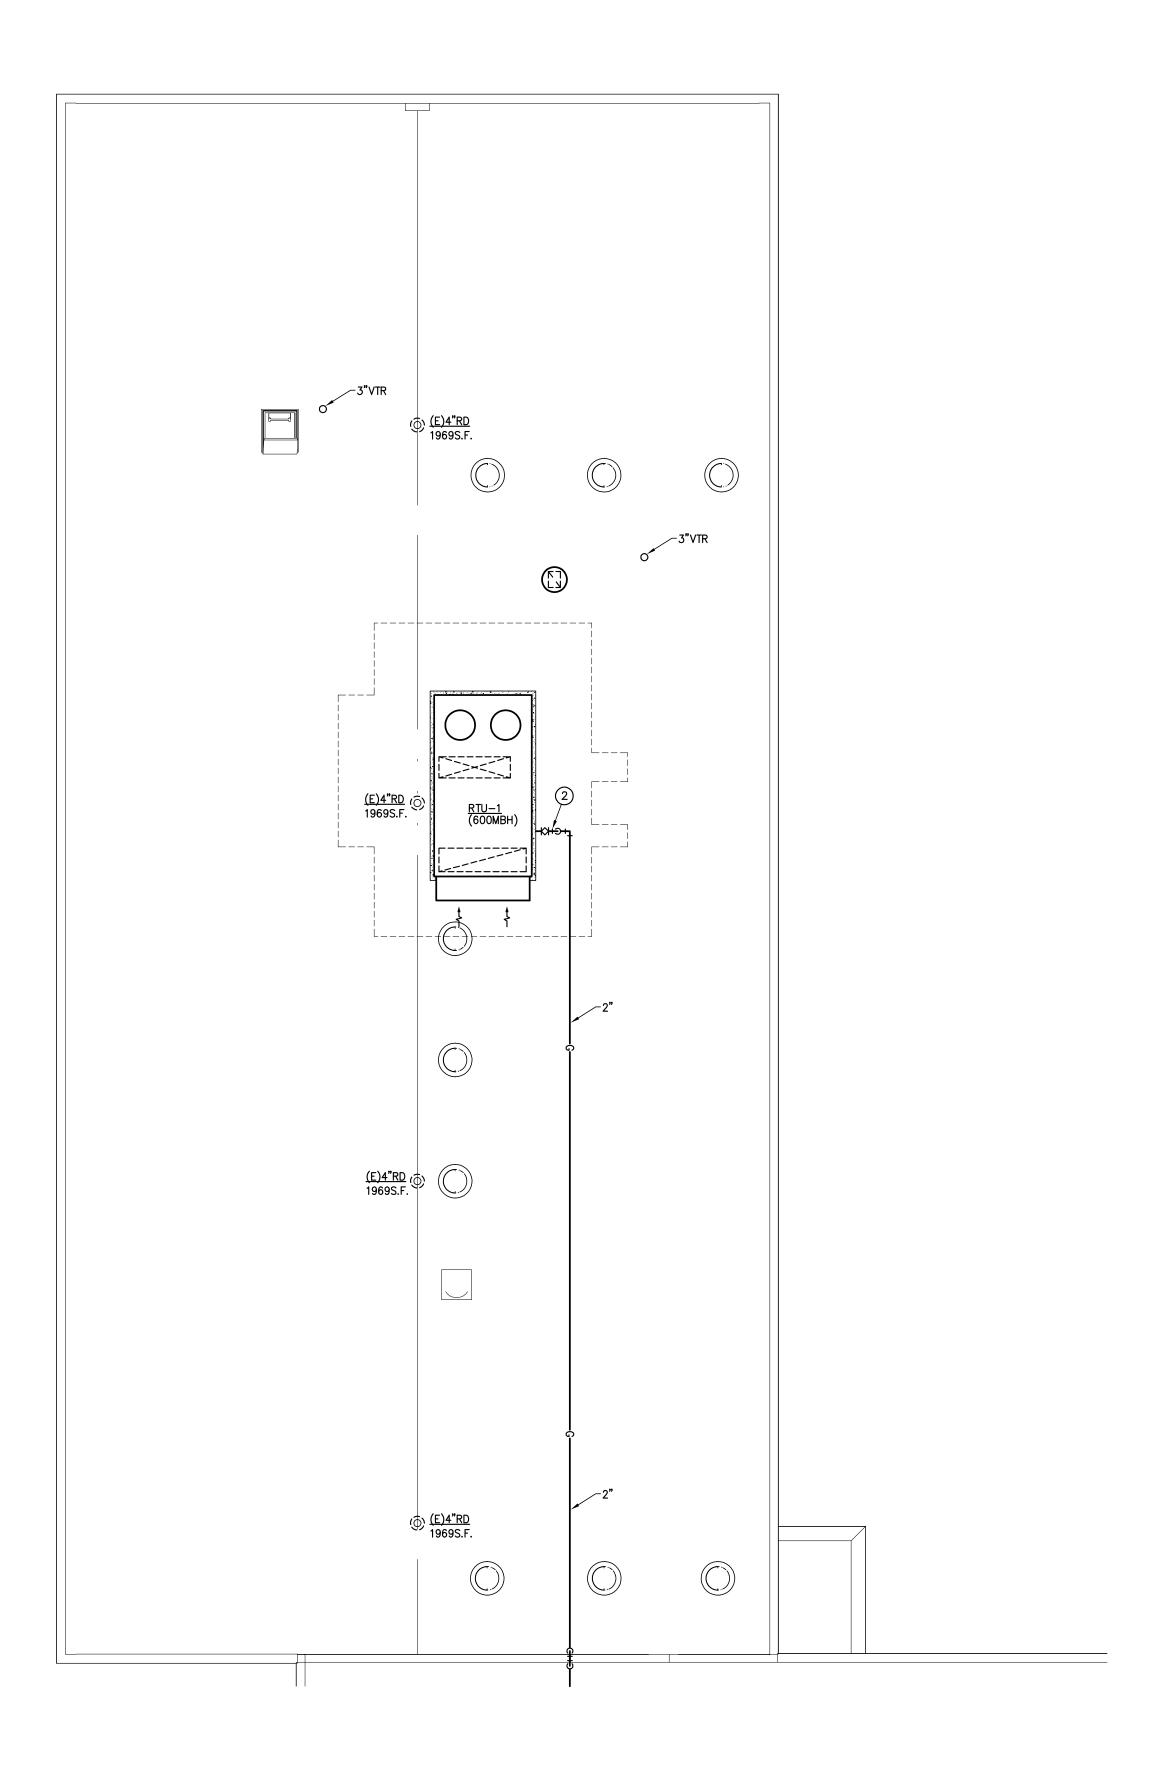




## PLUMBING KEYNOTES:


1 3" GAS LINE DOWN TO GAS METER.
2 2" GAS LINE TO RTU-1 W/ GAS COCK & 6" DIRT LEG.
3 2" GAS LINE TO RTU-2 W/ GAS COCK & 6" DIRT LEG.
4 2" GAS LINE TO RTU-3 W/ GAS COCK & 6" DIRT LEG.
ADD#4 5 2" GAS LINE TO MAU-1 W/ GAS COCK & 6" DIRT LEG.

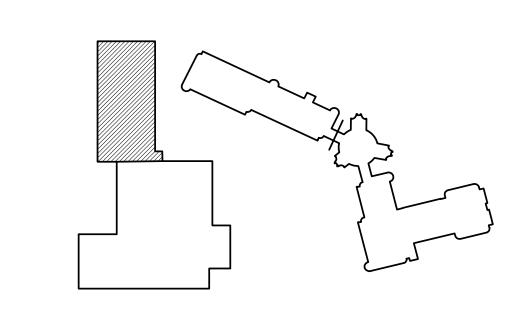


ADD#4	07.24.14	BID ADDEN	DUM #4			OZ	KY		
3	06.25.14	FOR CONS	TRUCTION			OZ	KY		
2	04.11.14	50% CONS	TRUCTION DOCUMENTS			OZ	KY		
1	01.10.14	100% SCHE	MATIC DESIGN / DESIGN DI	EVELOPI	MENT	OZ	KY		
VO.	DATE	DESCRIPTION	ON OF REVISION			AUTHORITY	MADE	APPR'D	
			DE SCHOOL DISTRICT	PARTI NO. 1	R PUBLIC SMENT OF FACILITY M. SCHOOL NO. 982 ENCE CRIT 113266.00 ZUNI STREET DENVER, COLORA	ANAGEMENT SITE NO. TENTON	DEN'	VER , CO	113
	ER PUBLIC DEPARTMEN CILITY MANA	NT OF	DESIGNED BY: FJG  DRAWN BY: FJG  CHECKED BY: TRH  DATE: June 25, 2014  SCALE: 1/8" = 1'-0"	1	ORTH WING UMBING PI	ROOF			/1101 - P-
ATE:			3003 Larin Denver, C phone 303 www.oza	O 8020 .861.57	05 04	DWG NO. P-113	_ /		970-684/1

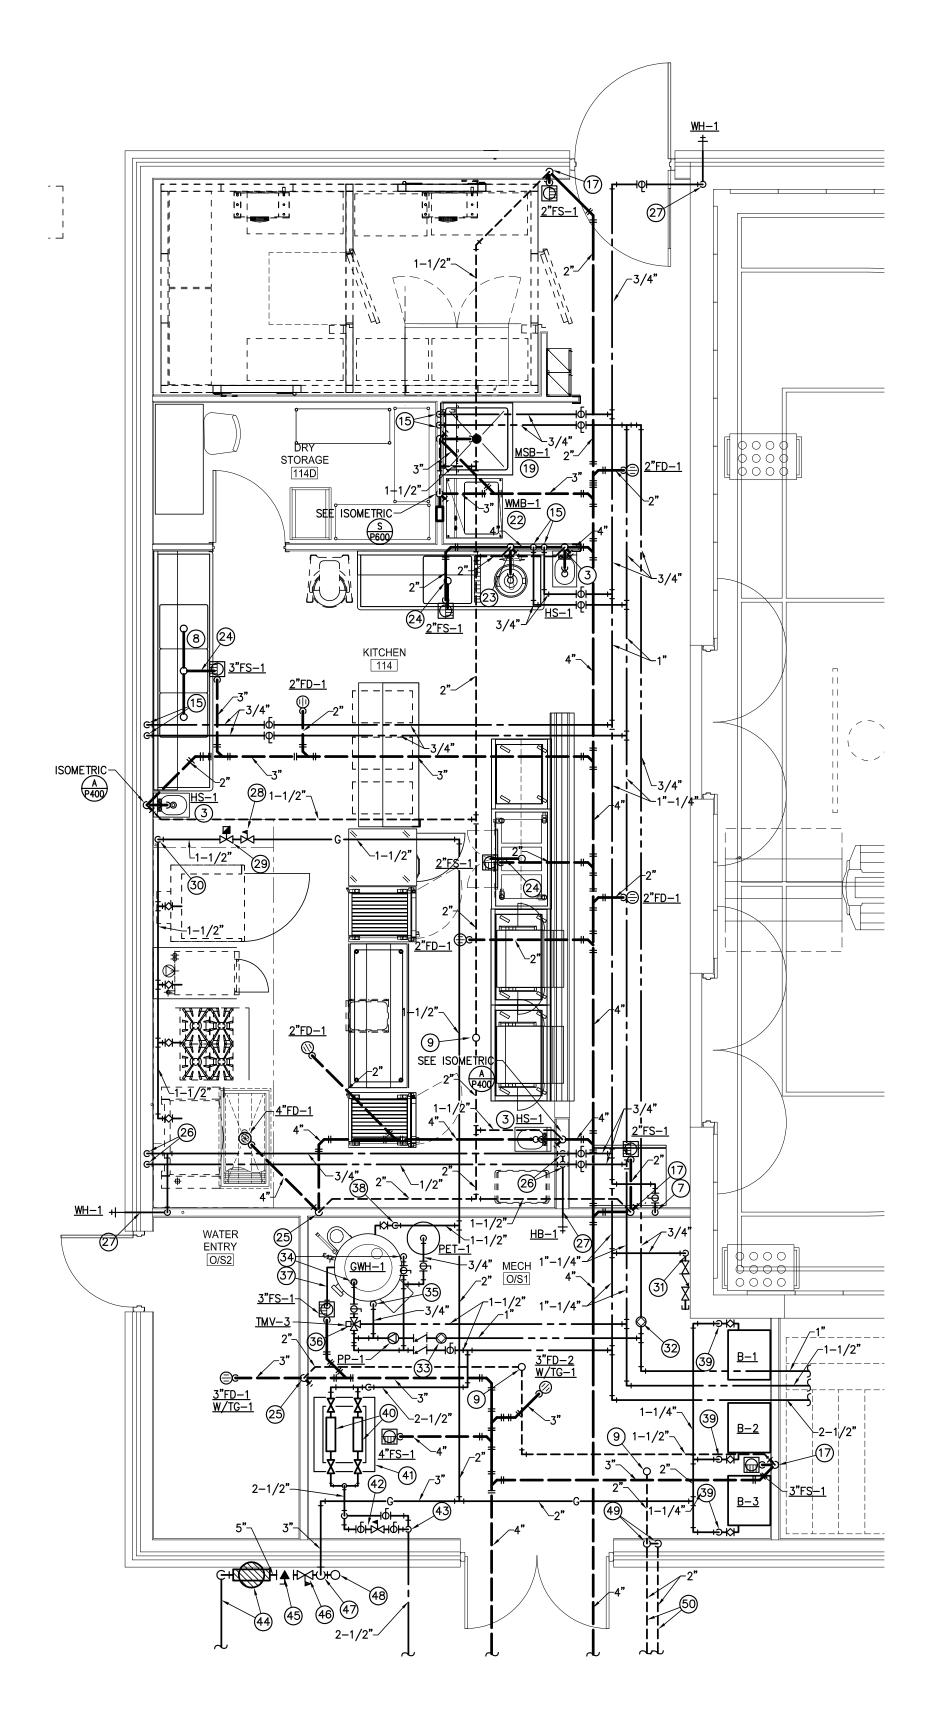



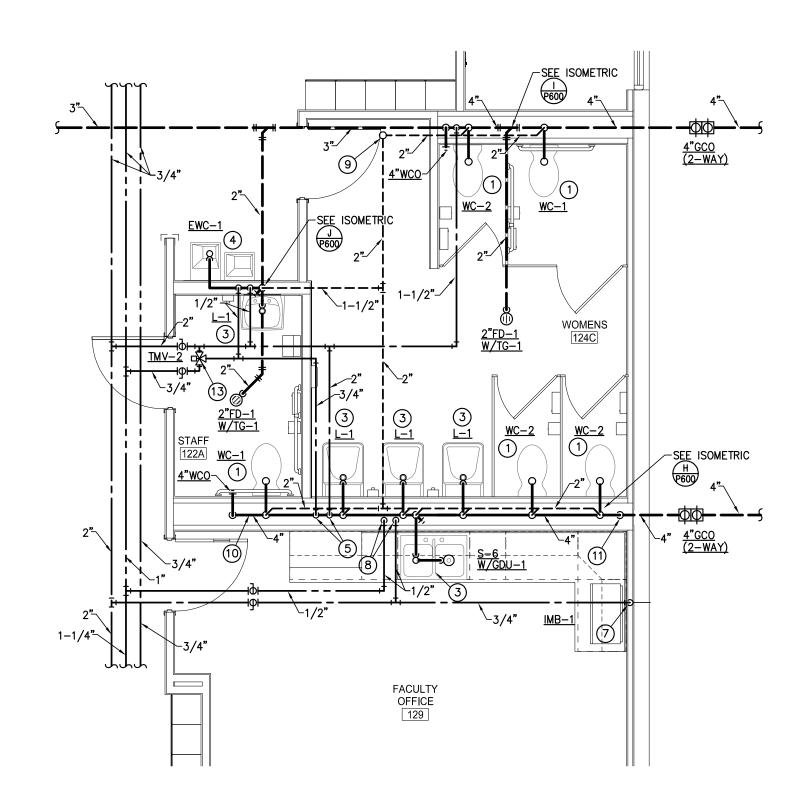

# RESTROOMS 124C/122A PLUMIBING PLAN SCALE: 1/4"=1'-0"

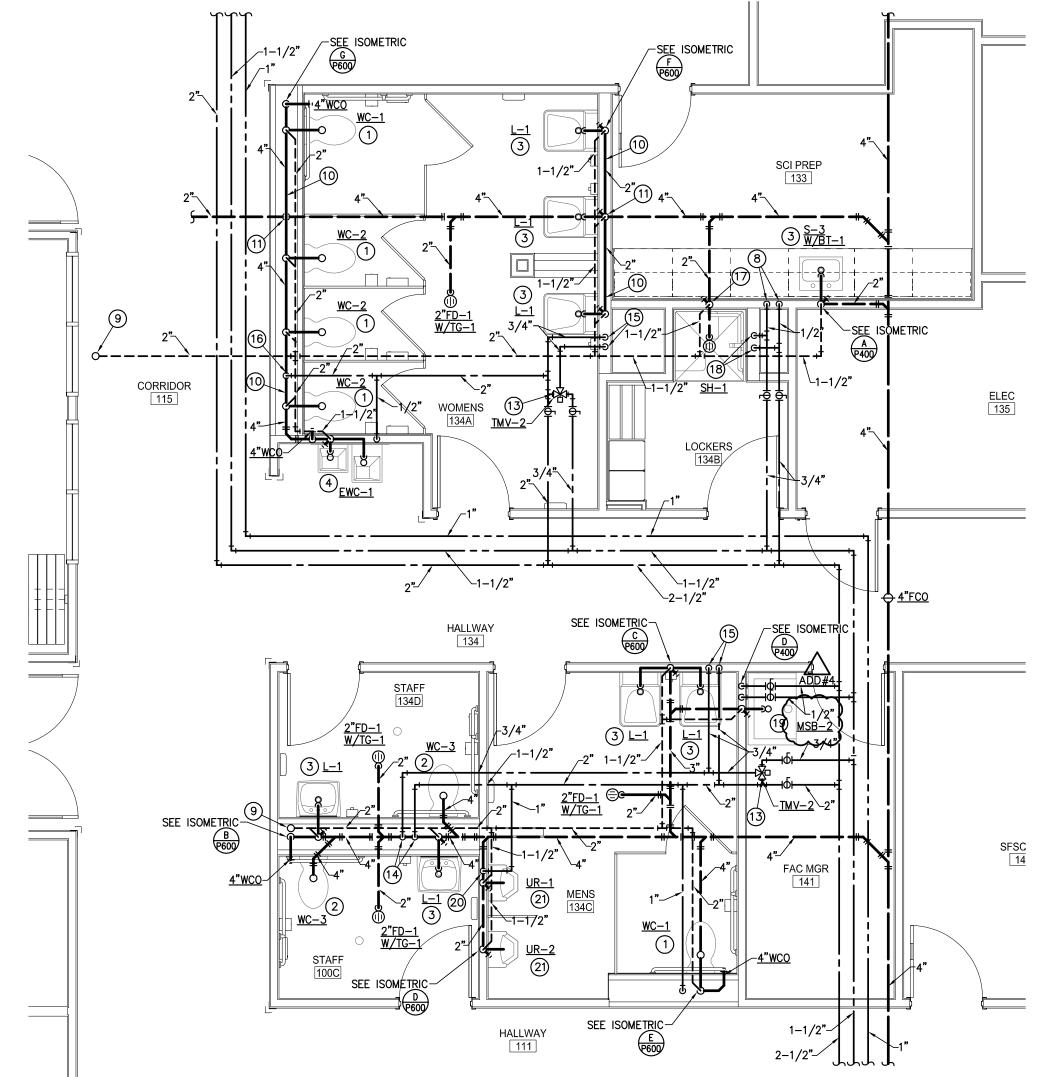



### PLUMBING KEYNOTES:

1) 4" W. DN., 2" V. RISE & 1" CW TO WATER CLOSET.

(2) 4" WASTE & 1" CW TO WATER CLOSET.

3 2" W. DN., 1-1/2" V. RISE, 1/2" CW & 1/2" HW TO LAVATORY/SINK.

4 2" W. DN., 1-1/2" V. RISE & 1/2" CW TO ELECTRIC WATER COOLER.

(5) 2" CW & 3/4" HW DOWN IN WALL AND OFFSET TO FIXTURES.

(6) 1-1/2" CW DOWN IN WALL AND OFFSET TO FIXTURES.

(7) 1/2" CW DOWN IN WALL TO ICE MAKER/ICE MAKER BOX.

(8) 1/2" CW & 1/2" HW TO SINK.

9) 2" VENT RISE TO 3" VTR. (10) WASTE LINE RUNNING ABOVE FLOOR SLAB.

(11) WASTE LINE DOWN AND OFFSET UNDERGROUND.

(12) 1/2" CW & 1/2" HW TO THERMOSTATIC MXING VALVE TMV-1 UNDER LAV/SINK.

(13) 3/4" CW & 3/4" HW TO THERMOSTATIC MXING VALVE TMV-2

(14) 1-1/2" CW & 3/4" HW DOWN IN WALL AND OFFSET TO FIXTURES.

(15) 3/4" CW & 3/4" HW DOWN IN WALL AND OFFSET TO FIXTURES.

(16) 2" CW DOWN IN WALL AND OFFSET TO FIXTURES.

17) 1-1/2" VENT RISE. (18) 1/2" CW & 1/2" HW DOWN TO SHOWER.

(19) 3" W. DN., 1-1/2" V. RISE, 1/2" CW & 1/2" HW TO MOP SINK.

(20) 1" CW DOWN IN WALL AND OFFSET TO FIXTURES.

(21) 2" W. DN., 1-1/2" V. RISE & 3/4" CW TO URINAL.

(22) 3" W. DN., 1-1/2" V. RISE, 1/2" CW & 1/2" HW TO WASHER BOX.

23 3" W. DN., 1-1/2" V. RISE, 3/4" CW & 1/2" HW TO GARBAGE DISPOSER, SEE DETAIL 11/P600.

24) DISCHARGE 2" DRAIN LINE TO FLOOR SINK W/ AIR GAP.

25) 2" VENT RISE.

(26) 3/4" CW & 1/2" HW DOWN IN WALL AND OFFSET TO FIXTURES.

(27) 3/4" CW TO WALL HYDRANT.

29 AUTOMATIC GAS SHUTOFF VALVE, TIE TO FIRE SUPPRESSION SYSTEM. PROVIDED BY HOOD FIRE SUPPRESSION SYSTEM, INSTALLED BY P.C.

(30) 1-1/2" GAS LINE DOWN W/ 6" DIRT LEG, OFFSET TO EQUIPMENT. (31) 3/4" CW DOWN W/ RP BACKFLOW FOR BOILER WATER MAKE-UP.

(32) BALANCING VALVE SET AT 2.0 GPM.

(33) BALANCING VALVE SET AT 5.0 GPM.

(34) 1-1/2" CW & 1-1/2" HW DOWN TO GAS WATER HEATER GWH-1. SEE DETAIL 1/P600.

(35) 1" HWC RETURN TO GHW-1 HWC CONNECTION.

(36) 1-1/2" CW & 1-1/2" HW TO THERMOSTATIC MIXING VALVE TMV-3.

(37) 3/4" CONDENSATE LINE DISCHARGE TO FLOOR SINK W/ AIR GAP. (38) 1-1/2" GAS LINE DOWN TO GAS WATER HEATER W/ GAS COCK & 6" DIRT LEG.

(39) 1-1/4" GAS LINE DOWN TO BOILER W/ GAS COCK & 6" DIRT LEG.

(40) (2) 2" BACKFLOW PREVENTERS WATTS #LF009 SERIES. SEE DETAIL 5/P600. (41) CONTAINMENT/SENSORING BASIN FOR BACKFLOW PREVENTERS. SEE DETAIL 12/P600.

(42) 2-1/2" DOMESTIC WATER PRESSURE REDUCING VALVE STATION. SEE DETAIL 6/P600.

(43) 2-1/2" DOMESTIC WATER LINE UP.

(44) NEW GAS METER/SERVICE BY UTILITY COMPANY, SEE GAS LOAD SCHEDULE ON SHEET P102.

(45) 5" GAS PLUG VALVE.


(45) 5" GAS PLUG VALVE.

(46) PROVIDE PRESSURE REDUCING VALVE (PASS-THRU) 21" W.C. INLET, 14" W.C. OUTLET 4,517MBH INPUT).

(47) 3" GAS LINE UP ON WALL AND OFFSET TO BUILDING IN CEILING SPACE.

(48) 3" GAS LINE UP TO ROOF. (49) (2) 2" VENT LINES DOWN IN WALL TO GREASE INTERCEPTOR.

(50) 2" VENT LINES TO GREASE INTERCEPTOR.

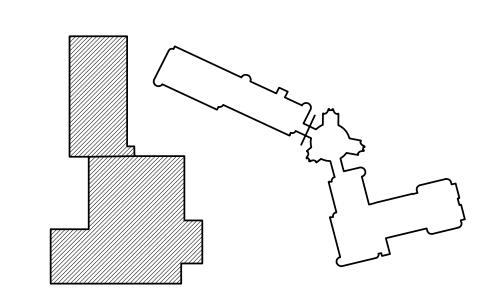

ADD#4	07.24.14	BID ADDEN	DUM #4	OZ	KY		
3	06.25.14	FOR CONS	TRUCTION		OZ	KY	
2	04.11.14	50% CONS	TRUCTION DOCUMENTS		OZ	KY	
1	01.10.14	100% SCHE	MATIC DESIGN / DESIGN DEVELOPM	MENT	OZ	KY	
NO.	DATE	DESCRIPTI	ON OF REVISION		AUTHORITY	MADE	APPR'D
			DEPARTI	MENT OF FACILITY MA	NAGEMENT		
				R PUBLIC S		_3	
			SCHOOL DISTRICT NO. 1	SCHOOL NO. 982	SITE NO.	DEN	VER , CO
			FLORI	ENCE CRIT	TENTON	1	
				113266.00 ZUNI STREET			




1/4" = 1'-0"

DRAWN BY: FJG
CHECKED BY: TRH

DENVER PUBLIC SCHOOLS

DEPARTMENT OF
FACILITY MANAGEMENT

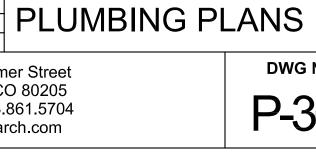

ENLARGED SCALE


PLAN	DESCRIPTION	MANUF.	MODEL	COLOR	FITTINGS	MANUF.	MODEL	COLOR	REMARKS
CODE WC-1	WATER CLOSET - ACCESSIBLE - 17"	KOHLER	K-4325	FINISH WHITE	SEAT	OLSONITE	95CC	FINISH WHITE	NOTES: 1,2
WC-2	(WALL HUNG) WATER CLOSET - 15"	KOHLER	K-4325	WHITE	FLUSH VALVE SEAT	SLOAN OLSONITE	ECOS-8111-1.28 95CC	CHROME WHITE	NOTE: 1
	(WALL HUNG)				FLUSH VALVE	тото	TMT1LN32#CP	CHROME	
WC-3	WATER CLOSET — ACCESSIBLE — 17"  (FLOOR MOUNTED)	KOHLER	K-4405	WHITE	SEAT FLUSH VALVE	OLSONITE SLOAN	95CC <b>E00S-8111-1.28</b>	WHITE CHROME	NOTE: 2
WC-4	WATER CLOSET — PRIMARY — 10" (FLOOR MOUNTED) TANK TYPE WATER CLOSET — ACCESSIBLE — 17"	AMERICAN STANDARD	2315.228	WHITE	SEAT	AMERICAN STANDARD	W/ TOILET	WHITE CHROME	
	(FLOOR MOUNTED) TANK TYPE				- <del>-</del> - · · ·				
WC-6	WATER CLOSET — 15" (FLOOR MOUNTED) TANK TYPE	KOHLER	K-3996	WHITE	SEAT	KOHLER	95CC	WHITE	
UR-1	URINAL (ACCESSIBLE)	KOHLER	K-5016	WHITE	FLUSH VALVE	SLOAN	8186-0.25	CHROME	NOTES: 1,2,4
UR-2	URINAL	KOHLER	K-5016	WHITE	FLUSH VALVE	тото	TMU1LN12#CP	CHROME	NOTES: 1,3
L-1	LAVATORY-WALL HUNG (ACCESSIBLE)	KOHLER	K-1721	WHITE	FAUCET	SLOAN	EFX-250-500-0010	CHROME	NOTES: 2,5,6,7, 8,9,14
L-2	LAVATORY-WALL HUNG (ACCESSIBLE)	KOHLER	K-1721	WHITE	FAUCET	CHICAGO	895-317-CP	CHROME	NOTES: 5,6,7, 8,9,14
S-1	SINK - (CLASSROOM 25")	ELKAY	DRKAD2217	STAINLESS STEEL	FAUCET	CHICAGO	50-E35ABCP	CHROME	NOTES: 5,9,10,
S-2	SINK - (CLASSROOM 36")	ELKAY	DRKAD2217	STAINLESS STEEL	FAUCET	CHICAGO	50-E35ABCP	CHROME	NOTES: 5,9,10,
S-3	SINK (SCIENCE)	ELKAY	DRKAD2217	316 STAINLESS STEEL	FAUCET	CHICAGO	930VR-369CP- GN2BVBJKCP-E7JKCP	CHROME	NOTES: 5,10, 14,18
S-4	SINK (SINGLE COMP.)	ELKAY	LRAD1919	STAINLESS STEEL	FAUCET	CHICAGO	786-317-CP	CHROME	NOTES: 5,9,10,
S-5	SINK (SINGLE COMP.)	ELKAY	LRAD2521	STAINLESS STEEL	FAUCET	CHICAGO	786-317-CP	CHROME	NOTES: 5,9,10,
S-6	SINK (DOUBLE COMP.)	ELKAY	LRAD3321	STAINLESS STEEL	FAUCET	CHICAGO	786-317-CP	CHROME	NOTES: 5,9,10,
S-7	SINK (ART)	ELKAY	WNSF8245LR	STAINLESS STEEL	FAUCET	CHICAGO	540-LDL9ABCP	CHROME	NOTES: 5,9,10,
HS-1	SINK (ACCESSIBLE)	KOHLER	K-2005	WHITE	FAUCET	CHICAGO	895-317-CP	CHROME	NOTES: 5,9,10,
MSB-1	MOP SERVICE BASIN	FIAT	MSB3636	WHITE	FAUCET	CHICAGO	445-RC897SXKCP	CHROME	14 NOTE: 11
MSB-2	MOP SERVICE BASIN	FIAT	MSB3624	WHITE	FAUCET	CHICAGO	445-RC897SXKCP	CHROME	NOTE: 11
EWC~1	ELECTRIC WATER COOLER	HAWS	<b>→#11/19.8</b> ~	STAIMLESS					NOTES: 1,12
	ELECTRIC WATER COOLER	HAWS	H1109.8	STEEL STAINLESS STEEL	-	-	-	_	NOTES: 1,12
SH-1	SHOWER	FIAT	36MFT	WHITE	VALVE HEAD	POWERS	E425-D-1-W	CHROME	NOTES: 15,17
S/EEW-1	EMERGENCY SHOWER/EYEWASH	HAWS	8317	_		_	-	_	
EEW-2	EMERGENCY EYEWASH	HAWS	7612	_	_	_	-	<del>-</del>	NOTE: 13
GDU-1	GARBAGE DISPOSAL UNIT	IN-SINK-ERATOR	BADGER5	_	-	-	-	-	NOTE: 16
NOTES:	. CARRIER, COORD. WALL THICKNESS W/ A	RCH PLANS 7	INSULATION KIT			13	PROVIDE HAWS TWBS.EWE T	HERMOSTATIC M	IXING VALVE

4. 5.	MOUNTED @ 24" AFF MOUNTED @ 17" AFF C.P. ANGLE SUPPLIES W/ L.K. STOPS, 17 GRID STRAINER, .50 GPM FLOW RESTRICTOR	10. GA. P—TRAP 11.	GRID STRAINER 1.5 GPM FLOW RESTRIC VACUUM BREAKER, CHE 120V/1PH/60HZ 1/5	ECK STOPS		16. 17.	15. 24" ADA BAR W/HAND HELD HEAD. 16. 120V/1PH/60HZ 3/4 H.P. 17. WITH 2" FD-1. 18. 316 STAINLESS STEEL DRAIN/STRAINER						
	WATER HEATER SCHEDULE (GAS-FIRED)												
PLAN	MANUFACTURER	STORAGE	G.P.H. RECOVERY	EFF. FLUE OPER.			REMARKS						
CODE	& MODEL NO.	GALLONS	@ 100' RISE	SEA LEVEL	FACTOR	SIZE	WEIGHT						
GWH-1	PVI CONQUEST 60-L-130A-GCML	130.0	691.0	600,000.0	000.0 0.97 6		1,307 LBS	NOTES: 1,2,3,4					


PLAN CODE	DESCRIPTION	MANUFACTURER	MODEL	FINISH	REMARKS		
PET-1	PLUMBING EXPANSION TANK	AMTROL	ST-30V-C	STEEL	NOTE: 1		
TMV-1	THERMOSTATIC MIXING VALVE	BRADLEY	S59-4000	ROUGH BRASS	NOTE: 2,5,7		
TMV-2	THERMOSTATIC MIXING VALVE	BRADLEY	S59-4016	ROUGH BRASS	NOTE: 2,5,7		
TMV-3	THERMOSTATIC MIXING VALVE	BRADLEY	HL130	ROUGH BRASS	NOTE: 4,6,7		
TMV-4	THERMOSTATIC MIXING VALVE	POWERS	S19-2100	ROUGH BRASS	NOTE: 7,8		
SI-1	SOLID INTERCEPTOR	WATTS	SI-742	CAST IRON	NOTE: 3		
BT-1	BOTTLE TRAP (ACID DILUTION)	ORION	BT-1 (2QT.)	POLYPROPYLENE			
2. A	SME CONSTRUCTION SSE 1070 OCATE OFF TO THE SIDE OF SINK W/ SEF		4. 40 GPM @ 12 PSI LOSS 5. SET AT 110°F 6. SET AT 120°F	7. LEAD-FREE 8. SET AT 80°F			

PLUMBING FIXTURE CONNECTION SCHEDULE												
	FIXTURE	PIPE SIZE (INCHES, MINIMUM)										
PLAN		V	WASTE		CC	DLD WATER	НОТ	REMARKS				
CODE		TRAP VERT.		VENT	SUPPLY CONNECTION		SUPPLY	CONNECTION				
		& ARM	DRAIN	(MIN.)	(MIN.)	(ACTUAL)	(MIN.)	(ACTUAL)				
WC	WATER CLOSET	INT.	4"	2"	1"	1"	-	-				
U	URINAL	INT.	2"	1-1/2"	3/4"	3/4"	_	-				
L	LAVATORY	1-1/2"	2"	1-1/2"	1/2"	3/8"	1/2"	3/8"				
S	SINK	1-1/2"	2"	1-1/2"	1/2"	1/2"	1/2"	1/2"				
SH	SHOWER	2"	2"	1-1/2"	1/2"	1/2"	1/2"	1/2"				
EWC/DF	ELEC. WATER COOLER/DRINKING FOUNT.	1-1/2"	2"	1-1/2"	1/2"	3/8"	_	-				
WH/HB	WALL HYDRANT	_	_	_	3/4"	3/4"	_	-				
ES/EEW	EMERGENCY SHOWER/ EYEWASH	_	-	_	1-1/4"	-	1-1/4"	-	TEPID WATER			
MSB	MOP SERVICE BASIN	3"	3"	1-1/2"	1/2"	1/2"	1/2"	1/2"				


	PUMP SCHEDULE														
				IMP.				ELECTRICAL							
PLAN	MANUFACTURER	TYPE	SERVICE	DIA.	GPM	HEAD	%	HP	VOLTS	Ø	RPM	VIBRATION	CONTROL	WEIGHT	REMARKS
CODE	& MODEL NO.			(IN)			EFF.	(BHP)				ISOLATION		(LBS)	
PP-1	B&G PL-36B	IN-LINE	120 <b>°</b> F	_	5.0	30'	_	2/5	115	1	_	INTEGRAL	DDC	1	NOTE: 1
NOTES:	NOTES:  1. DDC, OCCUPIED/UNOCCUPIED														

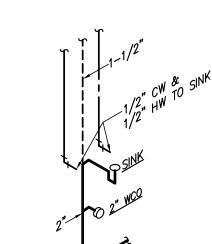


PLUMBING ISOMETRIC
SCALE: NONE

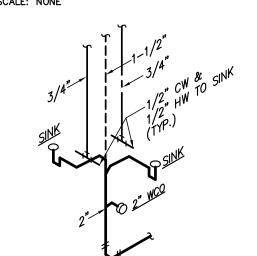



B PLUMBING ISOMETRIC
P400 SCALE: NONE

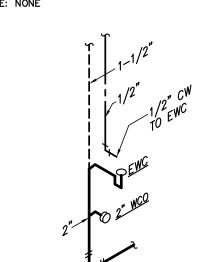


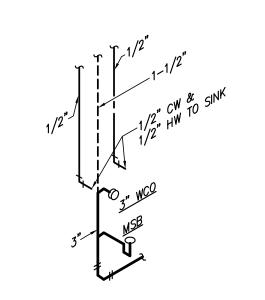

PLUMBING ISOMETRIC
P400 SCALE: NONE

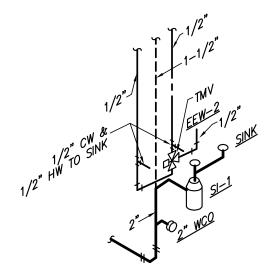

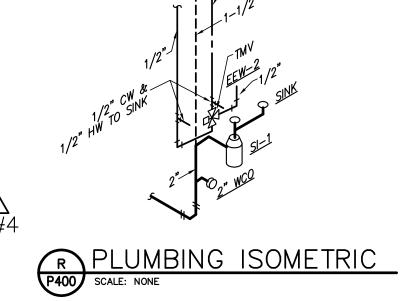

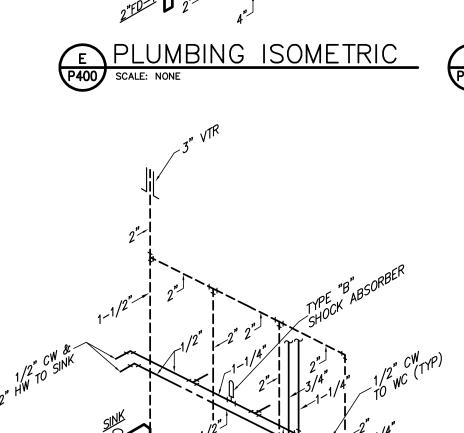

TANK TYPE GAS WATER HEATER SET TO 140°F OUTPUT WATER TEMP.


120V/1PH/60HZ 20AMP.
PROVIDE CONDENSATE NEUTRALIZATION KIT PER MFG REQUIREMENTS

PLUMBING ISOMETRIC


SCALE: NONE

PLUMBING ISOMETRIC


SCALE: NONE

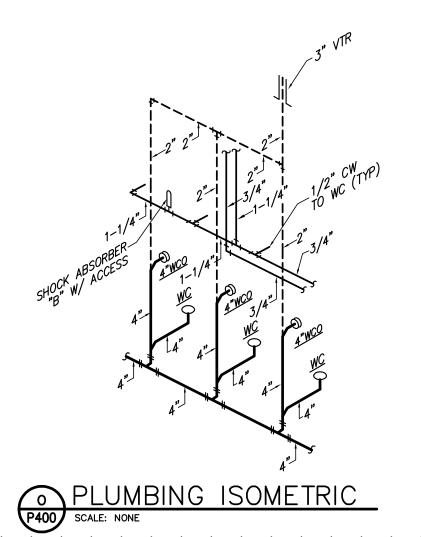


H PLUMBING ISOMETRIC
P400 SCALE: NONE

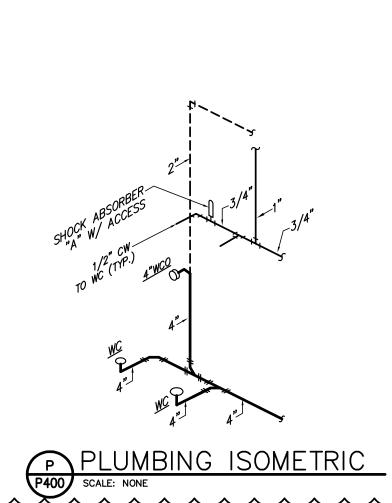

PLUMBING ISOMETRIC
P400 SCALE: NONE

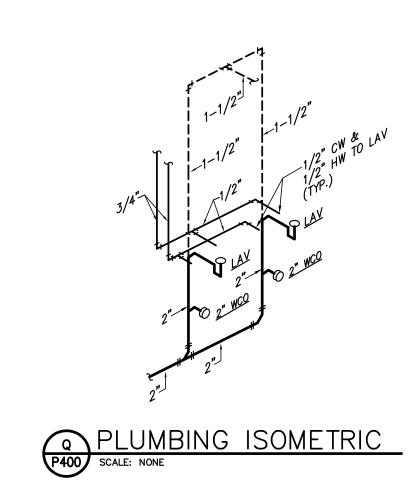

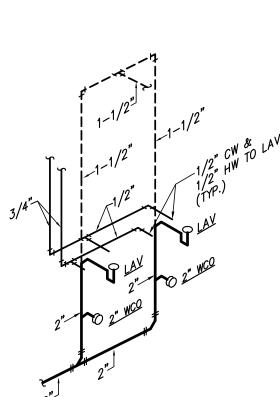

R PLUMBING ISOMETRIC
P400 SCALE: NONE


The Ballard Group, Inc.
Mechanical Consulting Engineers
(303) 988-4514

DENVER PUBLIC SCHOOLS

DEPARTMENT OF
FACILITY MANAGEMENT

FJG KED BY: TRH


NONE

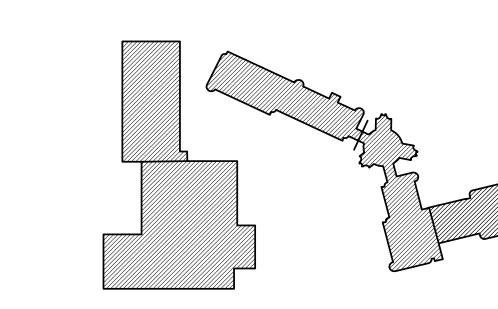

ADD#4 07.24.14 BID ADDENDUM #4 3 06.25.14 FOR CONSTRUCTION 2 04.11.14 50% CONSTRUCTION DOCUMENTS OZ KY OZ KY 1 01.10.14 100% SCHEMATIC DESIGN / DESIGN DEVELOPMENT AUTHORITY MADE APPR'D NO. DATE DESCRIPTION OF REVISION **DENVER PUBLIC SCHOOLS** DEPARTMENT OF FACILITY MANAGEMENT SCHOOL DISTRICT NO. 1 SCHOOL NO. 982 SITE NO. DENVER , CO FLORENCE CRITTENTON

113266.00 ZUNI STREET DENVER, COLORADO PLUMBING SCHEDULES June 25, 2014

3003 Larimer Street Denver, CO 80205 phone 303.861.5704 P-400 ARCHITECTURE www.ozarch.com

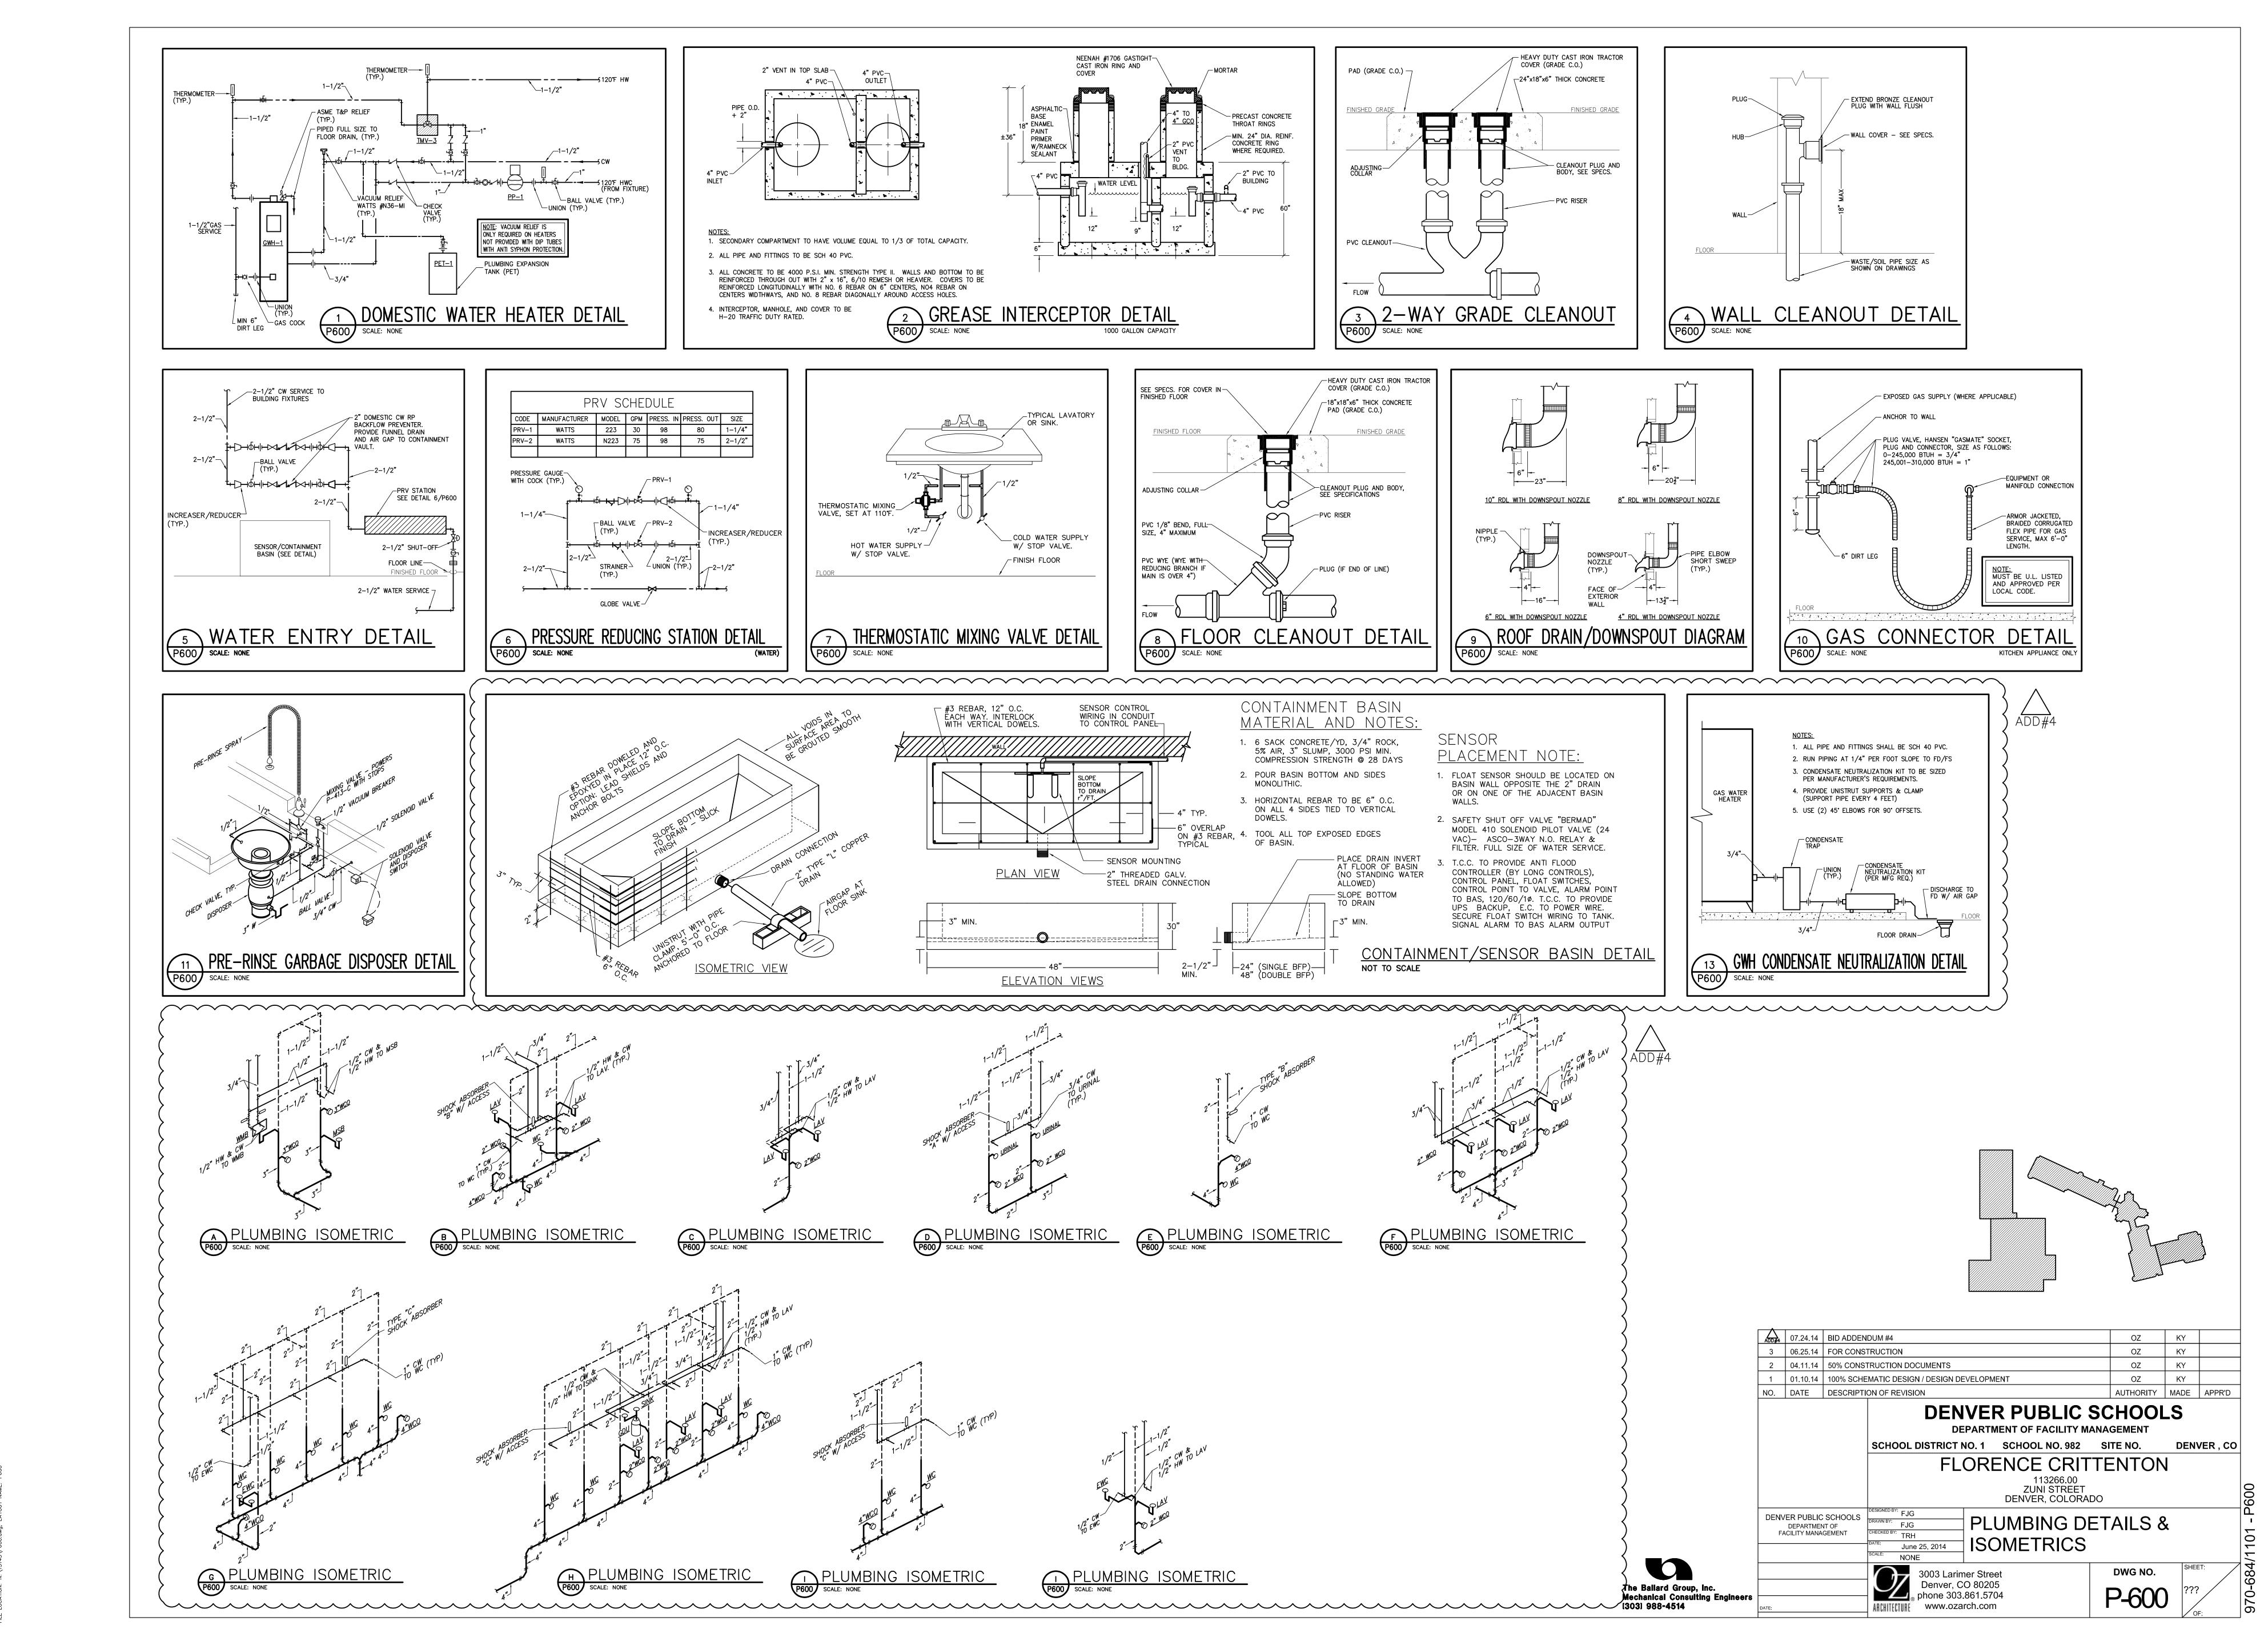

PLOT DATE: July 24, 2014 @ 6:02pm