

AmerGen

An Exelon/British Energy Company

Clinton Power Station

P.O. Box 678
Clinton, IL 61727
Phone: 217 935-8881

U-603434
8G.120

December 18, 2000

Docket No. 50-461

Document Control Desk
Nuclear Regulatory Commission
Washington, D.C. 20555

Subject: Clinton Power Station Response to Requests for Additional Information
Regarding Generic Letter 96-06 (TAC No. M96796)

Dear Madam or Sir:

The purpose of this letter from AmerGen Energy Company, LLC (AmerGen) is to provide additional information for supporting closure of the Clinton Power Station (CPS) response to Generic Letter (GL) 96-06, "Assurance of Equipment Operability and Containment Integrity During Design-Basis Accident Conditions." Clinton Power Station's initial response to GL 96-06 was provided via letter U-602654 dated October 28, 1996, and was supplemented by letter U-602686 dated January 28, 1997; letter U-602785 dated July 24, 1997, and letter U-603026 dated June 15, 1998.


Since submittal of the June 15, 1998, letter, CPS has received from the NRC two additional requests for information. These requests were by letter dated August 11, 1998, and by facsimile on August 21, 2000. The August 11, 1998, request for additional information concerns the modifications implemented at CPS for containment piping penetrations susceptible to thermally induced overpressurization. The August 21, 2000, request primarily concerns the potential for condensation induced water hammer. Although the first request was issued in 1998, the CPS response to that request was not due until within 45 days following completion of the evaluations for the subject modifications. Since the last of the required evaluations for these modifications was completed during the recently completed refueling outage (RF-7), the CPS response is provided accordingly and is provided in conjunction with the CPS response to the more recent August 21, 2000, request for additional information.

Responses to both requests for additional information, including supporting information, are provided in the attachments to this letter. Attachment 1 provides the responses to the questions contained in the August 11, 1998, request. Attachment 2 provides the responses to the questions received via the August 21, 2000, facsimile. Attachment 3 provides supplemental descriptive information about the systems that are the subject of Attachment 2. Finally, a listing of all applicable CPS containment penetrations subject to

A072

the requirements of GL 96-06, including identification of the final means of disposition for each penetration, is provided as Attachment 4.

Sincerely yours,

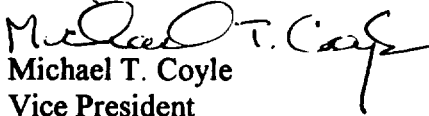
Michael T. Coyle
Vice President

DAN/TBE/blf

Attachments

cc: NRC Clinton Licensing Project Manager
NRC Resident Office, V-690
Regional Administrator, Region III, USNRC
Illinois Department of Nuclear Safety

Response to August 11, 1998, Request for Additional Information

The information requested by the NRC in its August 11, 1998, letter concerning the Clinton Power Station (CPS) response to GL 96-06 is provided below. These responses to the NRC questions concern the 7 piping penetrations that Clinton Power Station stated would be modified during the next refueling outage (RF-7) to eliminate the need to monitor and analyze containment isolation leakage.

1. Provide a specific description of the modifications to these 7 penetrations.

AmerGen Response:

The 7 penetrations identified in Clinton Power Station's July 24, 1997, letter, as well as descriptions of the modifications performed for the penetrations, are as follows:

Penetration Number	Penetration Description	GL 96-06 Resolution	Resolution Status
1MC-050	Make-up Condensate (line 1MC06B)	Relief valve to be installed between the containment isolation valves to prevent over-pressurization of the piping and valves.	Modifications completed.
1MC-065	Radwaste Repro. & Disposal (line 1WX12B)		
1MC-069	Drywell Equipment Drains (line 1RE14F)	Isolation valves are air-operated globe valves (spring to close). When pressure under the disk builds sufficiently to overcome spring force and air pressure, the valve will lift and relieve pressure.	Calculations are complete. No modifications are required.
1MC-070	Drywell Floor Drains (line 1RF26E)		
1MC-086	Reactor Water Cleanup to Condenser (line 1RT23)	ASME Appendix F methodology to be used to demonstrate that penetration will deform plastically, but will not rupture.	Calculations are complete. No modification is required.
1MC-103	Drywell Supplemental Chilled Water Supply (line 1WOHIC)	A hole will be drilled in the inboard disk of the inboard containment isolation valve (flex wedge gate) to relieve pressure. This modification was explained in more detail on page 3 of Attachment 2 to the CPS submittal dated January 28, 1997.	Modifications completed.
1MC-104	Drywell Supplemental Chilled Water Return (line 1WOK3C)		

2. If the modifications involve heat transfer and/or structural analyses of the piping segments, then the following information should be provided:

AmerGen Response:

Heat Transfer Analyses

Containment penetrations 1MC-050, -065, -069 and -070 are provided with a spring-loaded pressure relief mechanism. No heat transfer analysis is required for these penetrations.

Penetration IMC-086 was not evaluated using heat transfer analysis. The analyses for this penetration assumed that the fluid temperature stabilized at peak containment temperature. No heat-up rate was determined.

A bounding heat transfer calculation was performed for penetrations IMC-103 and -104 to verify that the relief path provided by the flexed disk and the hole drilled in the opposite disk would pass sufficient flow to prevent further pressure accumulation. This calculation assumed the maximum temperature difference (40°F fluid and 185°F containment atmosphere) occurs instantaneously after the valves close and did not credit the installed insulation. An extremely conservative heat transfer coefficient of 1000 BTU/hr-°F-ft² was used.

Structural Analyses

Piping, valve, and penetration stresses in all 7 of these penetrations were either completely reanalyzed or verification of margin was performed. For penetrations IMC-050 and -065 re-analysis was required for all service levels because relief valves were added, which changed loading for all service conditions. Penetrations IMC-069 and -070 were re-evaluated only for increased pressure stress. The design pressure of the piping at penetration IMC-069 was increased, so all service levels were evaluated. Penetrations IMC-070, -103 and 104 were re-evaluated for increased pressure stress for Service Level D only.

Elastic-plastic structural analysis of the piping, valves and penetration at IMC-086 was performed in accordance with ASME Section III, Appendix F.

- a. Provide the applicable design criteria for the piping and valves. Include the required load combinations;**

AmerGen Response:

All of the subject lines are ASME Section III, Class 2 between the containment isolation valves. The load combinations for Class 2 piping are summarized as follows:

ASME Equation #	Service Level	Load Combination (Class 2 Stress)	Acceptance Criteria
8		Design Pressure and weight	1.0S _h
9	B	Design Pressure and Weight and Combined (OBE _{response} + Pool Loads)	1.2S _h
9	C	Design Pressure ¹ and Weight and Combined (SSE _{response} + Pool Loads)	1.8S _h
9	D	Design Pressure ¹ and Weight and Combined (SSE _{response} + Pool Loads) ²	2.4S _h
10		Thermal Range Set + OBE _{building displacement}	

¹ Pressure term adjusted for Level C and D loads as required.

² Faulted loads may also be evaluated in accordance with methods and criteria of ASME Appendix F

These loading combinations and acceptance criteria are as described in the CPS USAR.

- b. Provide a drawing of the piping run between the isolation valves. Include the lengths and thicknesses of the piping segments and the type and thickness of the insulation.**

AmerGen Response:

The analytical drawings (used for the stress analysis) for the piping through each of the seven penetrations are included in this attachment. These drawings contain dimensions, pipe size, wall thickness, and insulation thickness. The insulation is only of concern for the weight loading imposed on the piping, since it was not credited in the heat transfer calculations.

- c. Provide the maximum-calculated temperature and pressure for the pipe run. Describe, in detail, the method used to calculate these pressure and temperature values. This should include a discussion of the heat transfer model used in the analysis and the basis for the heat transfer coefficients used in the analysis.**

A bounding heat transfer calculation was performed for penetrations IMC-103 and -104 to verify that the vent path provided by the flexed disk and the hole drilled in the opposite disk would pass sufficient flow to prevent further pressure accumulation. This calculation assumed the maximum temperature difference (40°F fluid and 185°F containment atmosphere) occurs instantaneously after the valves close and did not credit the installed insulation. The maximum temperature difference produces the highest thermal expansion rate. An extremely conservative heat transfer coefficient of 1000 BTU/hr-°F-ft² was used.

The heat transfer calculation used the basic formula:

$$\frac{dT_f}{dt} = \frac{UA(T_c - T_f)}{MC_p}$$

where: $\frac{dT_f}{dt}$ is the change in fluid temperature per unit time

U is the overall heat transfer coefficient, set to 1000 BTU/hr-°F-ft²
A is surface area for heat transfer
T_c is the temperature of the containment
T_f is the temperature of the fluid inside the piping
M is the mass of the fluid inside the piping
C_p is the heat capacity of water


This formula was used to determine the rate of heat transfer to the fluid volume between the containment isolation valves. The result was used to determine the rate of volume change due to thermal expansion. The rate of volume change was converted to a relief rate (i.e., leak rate) required to prevent a further increase in pressure.

The gap created when the disk flexes and the hole drilled in the opposite disk were treated as series orifices. The differential pressure required to produce a leak rate that exceeds the required relief rate was determined. The pressure to overcome seating forces and downstream pressure were added to produce the total pipe pressure. The piping, valves and penetration assemblies were then analyzed for this higher pressure using Service D allowables.

The final fluid temperature was not calculated, but was assumed to be in equilibrium with the containment (i.e., 185°F). Since the maximum rate of temperature change occurs at the maximum differential temperature between the fluid and the atmosphere and provides the limiting conditions in this methodology, the final temperature is not important. The maximum calculated differential pressure across the disks is 200 psid.

Penetrations 1MC-050, -065, -069 and -070 were not evaluated using heat transfer methods. The maximum calculated pressure for these penetrations is a direct function of the relief devices. Standard methods of performing stress analysis were used, using the same computer code.

EMD-028954
ADDENDUM E
PAGE 18

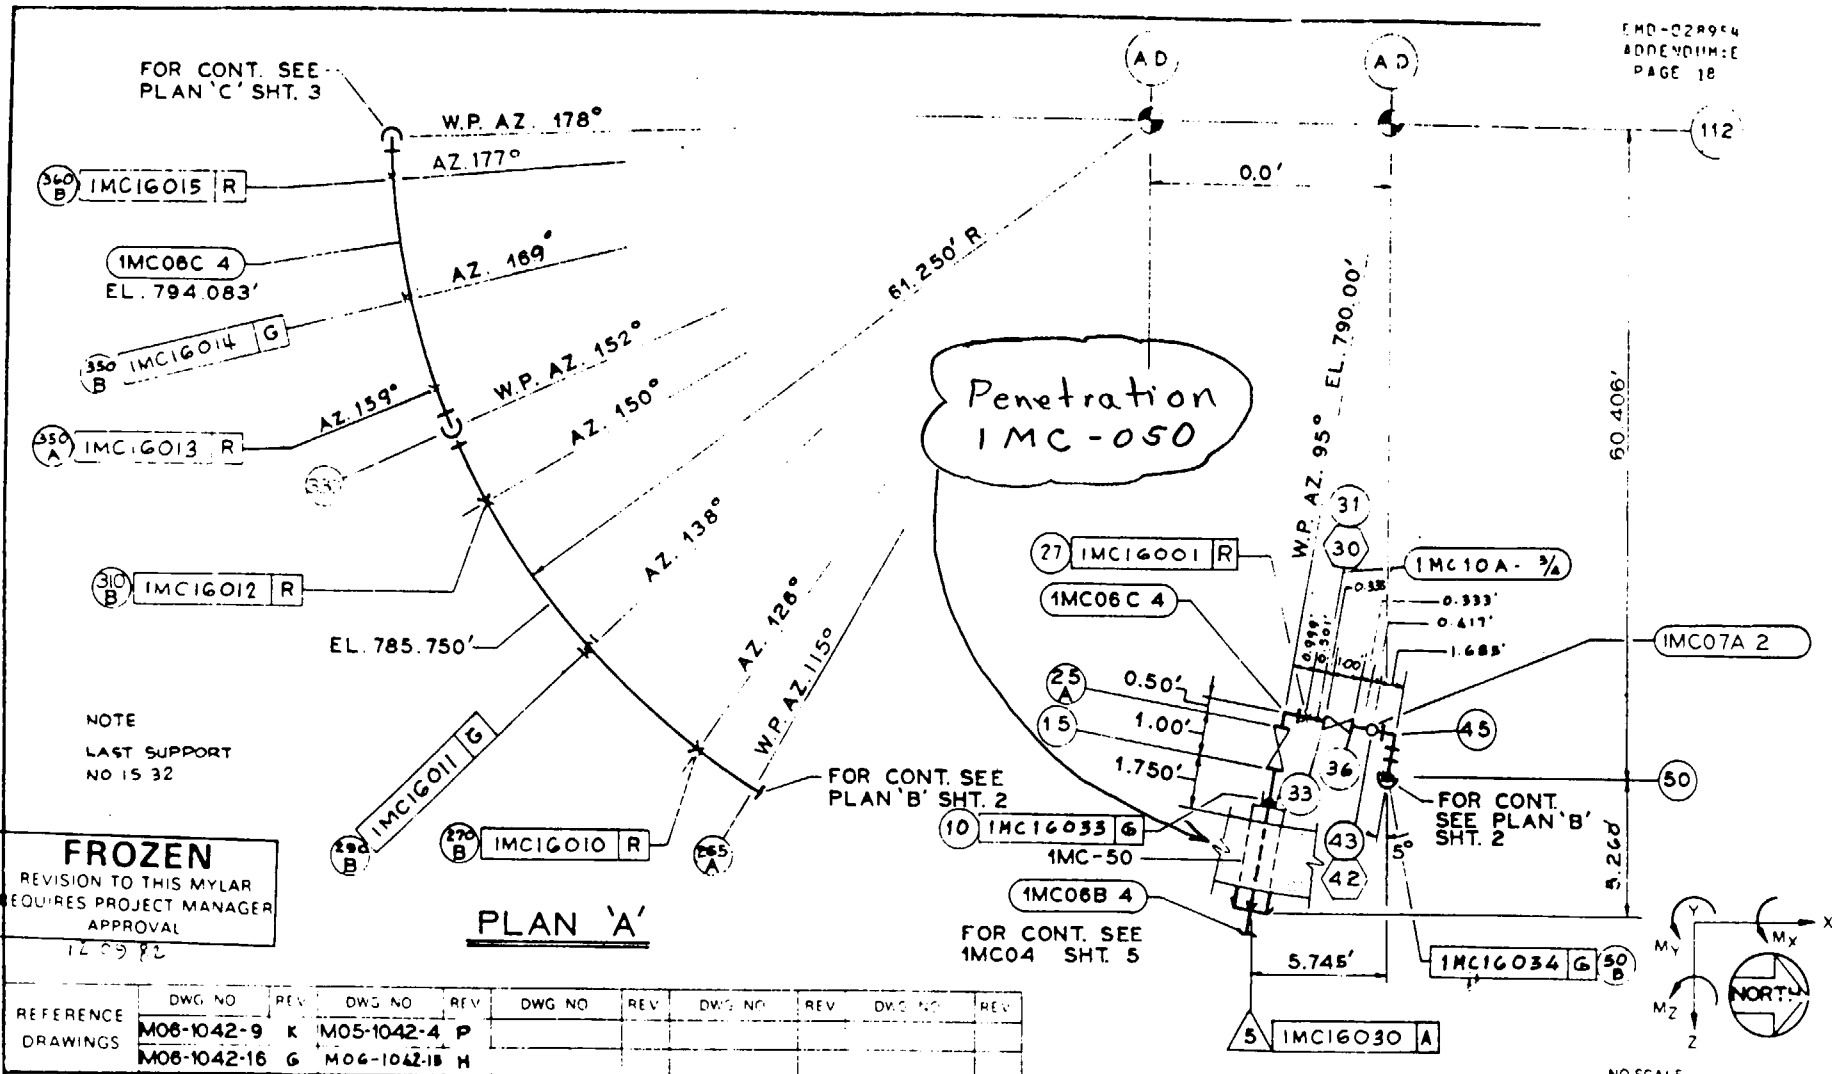

NOTE
LAST SUPPORT
NO 15 32

FROZEN
REVISION TO THIS MYLAR
REQUIRES PROJECT MANAGER
APPROVAL
12-09-82

PLAN 'A'

REFERENCE DRAWINGS	DWG NO	REV	DWG NO	REV	DWG NO	REV	DWG NO	REV	DWG NO	REV
	M06-1042-9	K	M05-1042-4	P						
	M06-1042-16	G	M06-1042-15	H						

RELEASE RECORD				
DATE	PREPARED	REVIEWED	APPROVED	PURPOSE
06-28-78	<i>J. J. ...</i>			
04-20-79	M U ARCEO			FOR EXTENDED TO 51" PER DRR POSIT RELOCATED SOME HANGERS UPDATED BASED ON LATEST SINGLE DWG PER DRR
08-30-79	M U ARCEO			UPDATED PER SYS. DWG
02-20-81	<i>D. ...</i>	<i>M. ...</i>	<i>P. ...</i>	FOR ANALYSIS
12-21-84	<i>E. ...</i>	<i>P. ...</i>	<i>M. ...</i>	FOR ANALYSIS

PIPING ANALYTICAL & PHYSICAL DATA	
FOR	MAKE-UP CONDENSATE STORAGE SYSTEM
PROJECT	CLINTON UNIT-1
CLIENT	ILLINOIS POWER CO.
PROJECT NO.	4536

SARGENT & LUNDY ENGINEERS CHICAGO	
SUB SYSTEM NO.	1MC16
REV	5
SHEET 1 OF 6	

Penetration 1MC-050

REV	NODE POINTS		LINE NUMBER	PIPE CLASS	PIPING DESIGN TABLE	MATERIAL		DESIGN PRESS	MAX OPER		O.D.	SCHED	WALL THICK	INSUL THICK	WEIGHTS - LBS/LINEAL FT.						
	FROM	TO				SPEC	GR		PRESS	TEMP					1 PIPE	2 OPER ELUM	3 INSUL	OPER TOTAL	1-2-3	4 WATER	HYDRO 1-4
															10.79	5.51	2.25	10.55	5.51	16.30	
5	5	15	1MC06B 4	B	106 CP	SA-106	B	150	129	90	4.50	40	0.237	0.50	10.79	5.51	2.25	10.55	5.51	16.30	
	25A	30	1MC06C 4	D	100	SA-106	B	150	129	90	4.50	40	0.237	0.50	10.79	5.51	0.88	17.18	5.51	16.30	
	40	720B	1MC06C 4	D	100	SA-106	B	150	129	90	4.50	40	0.237	0.50	10.79	5.51			5.51	16.30	
	42	43	1MC07A 2	D	100	SA-106	B	150	129	90	2.375	80	0.218	0.38	5.022	1.28	0.48	6.78	1.28	6.30	
	185	187	1MC40AA 2	D	100	SA-106	B	150	129	90	2.375	80	0.218	0.38	5.022	1.28					
	185	188	1MC40AB 2	D	100	SA-106	B	150	129	90	2.375	80	0.218	0.38	5.022	1.28					
	250	253	1MC39A 2	D	100	SA-106	B	150	129	90	2.375	80	0.218	0.38	5.022	1.28					
	605	607	1MC37A 2	D	100	SA-106	B	150	129	90	2.375	80	0.218	0.38	5.022	1.28					
	737	738	1MC38AA 2	D	100	SA-106	B	150	129	90	2.375	80	0.218	0.38	5.022	1.28					
	740	745	1MC38AB 2	D	100	SA-106	B	150	129	90	2.375	80	0.218	0.38	5.022	1.28					
	30	31	1MC10A-3/4	D	100	SA-106	B	150	129	90	1.050	80	0.154	0.38	1.47	0.188	0.20	1.94	0.188	1.66	

REV	NODE POINTS		TYPE	PRESSURE RATING	VAL STROKING TIME (SEC)		VAL/FIT. WT. LBS.		OPERATOR WT. LBS.		FLEXIBILITY INFO.		VENDOR	DRAWING NO.	REMARKS
	FROM	TO			OPEN	CLOSE	PRELIM.	ACTUAL	PRELIM.	ACTUAL	O.D.	THICK			
3	15	25A	GATE	150				*335			4.50		ANCHOR/DARLING VALVE CO.	93-15093	OMC010
4	33	36	GATE	150				83			4.50		CRANE CO.	K-6738	1MC009
4	182	183	CAP	150			3				4.50		CRANE CATALOGUE		
5	190	192									4.50				
	765	770									4.50				
								* INCLUDE OPERATOR							

EMD-028954
ADDENDUM: E
PAGE 22

REV	DATE	PREPARED	CHECKED	ENG'R APP'L	REV DESCRIPTION	FILM
		<i>Andrew...</i>				
2	08-30-79	M. Williams				
3		<i>Williams</i>			UPDATED PER SYS. DWG	
4	02-20-81	O. Daniel	<i>Man...</i>	R. W. Evans	FOR ANALYSIS	
5	12-21-84	E. Kuznetsov	<i>P....</i>	<i>...</i>	UPDATED PIPE & VALVE DATA FOR EMD EVALUATION	


PIPING ANALYTICAL & PHYSICAL DATA
FOR MAKE-UP CONDENSATE STORAGE SYSTEM
PROJECT CLINTON UNIT-1
CLIENT ILLINOIS POWER CO.
PROJECT NO. 4536

SARGENT & LUNDY
ENGINEERS
CHICAGO

SUB SYSTEM NO. 1MC16
REV. 5
SHEET 5 OF 6

MS-15-142-18-20 FORM APPROVED BY DATE DEPT MGR

EMC-D44235
ADDENDUM: B
PAGE 17

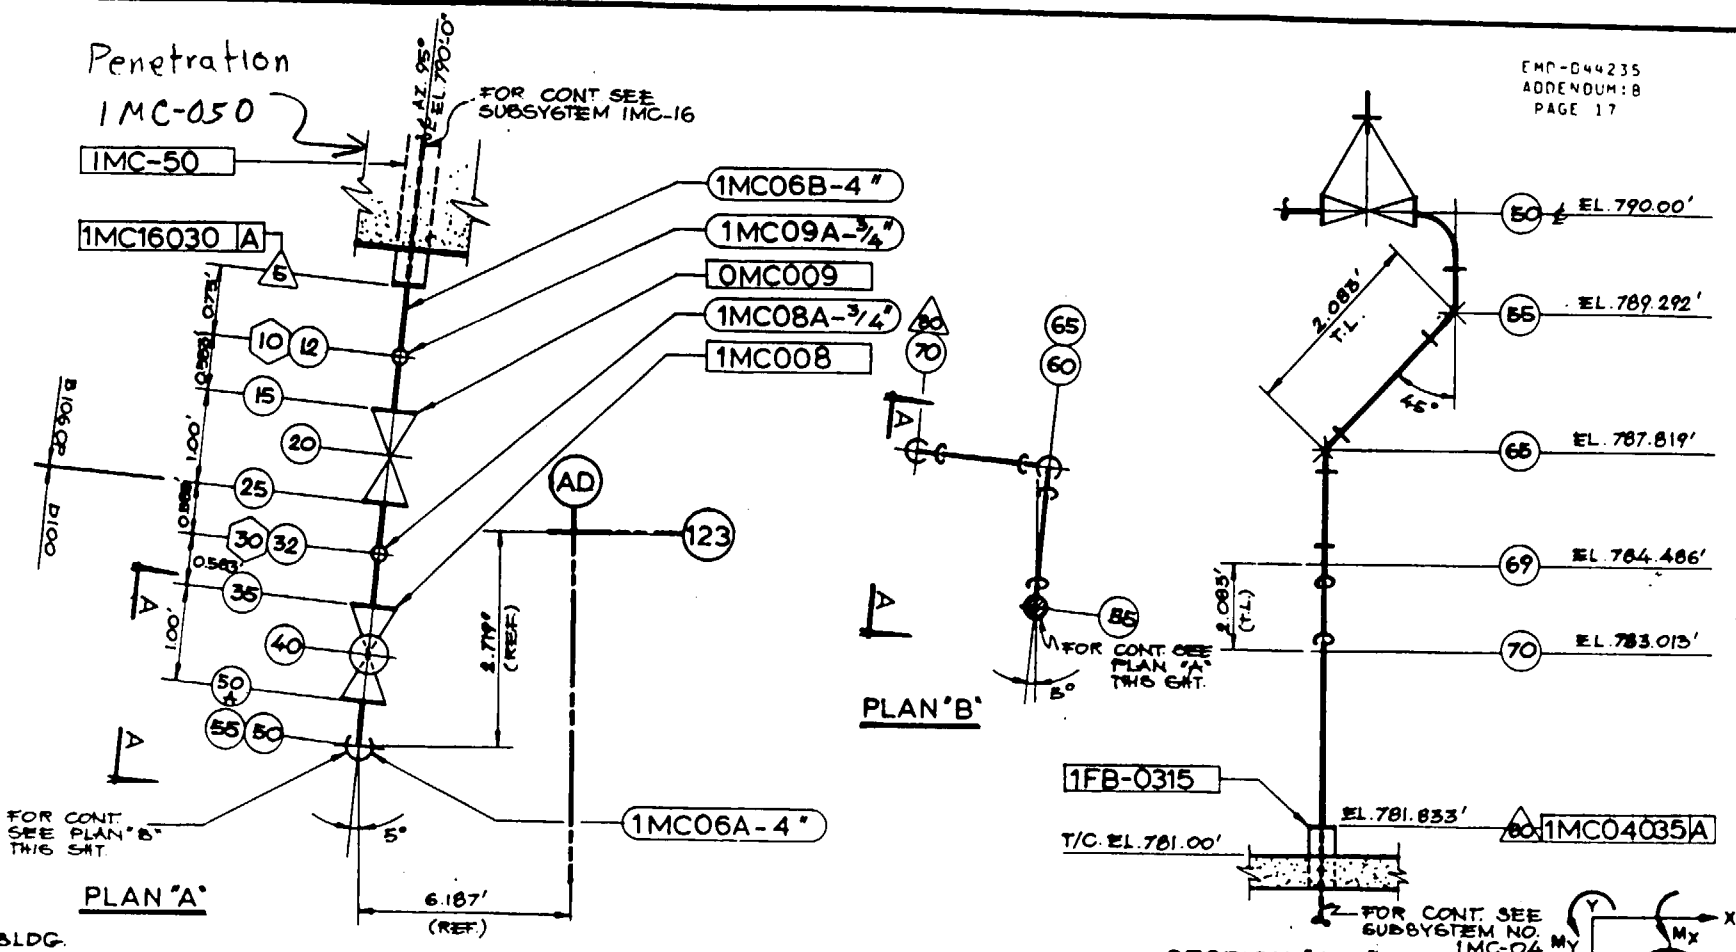

Form MES-6.4.1 Approved by *H. H. Hagan*
 Rev. A (10-14-77) DEPT. HBT.

REFERENCE DRAWINGS	DWG. NO.	REV.	DWG. NO.	REV.	DWG. NO.	REV.	DWG. NO.	REV.	DWG. NO.	REV.
	M06-1042-9	M	M05-1042-4							
	M06-1042-10	G								

RELEASE RECORD					
REV	DATE	PREPARED	REVIEWED	APPROVED	PURPOSE
0	10-17-83	<i>[Signature]</i>	<i>[Signature]</i>	<i>[Signature]</i>	FOR FMD COMMENTS
1	11-15-83	<i>[Signature]</i>	<i>[Signature]</i>	<i>[Signature]</i>	FOR ANALYSIS
2	11-21-84	<i>[Signature]</i>	<i>[Signature]</i>	<i>[Signature]</i>	UPDATED PIPE & VALVE DATA PER AT&T WORK LOG & TENDR PWD

PIPING ANALYTICAL & PHYSICAL DATA
 FOR MAKE-UP CONDENSATE STORAGE SYSTEM
 PROJECT CLINTON POWER STATION UNIT-1
 CLIENT ILLINOIS POWER COMPANY
 PROJECT NO. 4536-00

NO SCALE

SARGENT & LUNDY

SUB SYSTEM NO. 1 MC-04 B

REV. 2

SHEET 1 OF 5

Penetration IMC-050

REV.	NODE POINTS		LINE NUMBER	PIPE CLASS	PIPING DESIGN TABLE	MATERIAL		DESIGN PRESS.	MAX. OPER.		O.D.	SCHED.	WALL THICK	INSUL. THICK	WEIGHTS - LBS/LINEAL FT.					
	FROM	TO				SPEC.	GR.		PRESS.	TEMP.					1. PIPE	2. OPER FLUID	3. INSUL.	OPER TOTAL	1+2+3	4. WATER
		25	80	1MC06A-4"	D	100	ASTM A106	B	150	129	90	4.500	40	0.237	1.0"	10.79	5.51	1.40	17.70	-
	10	12	1MC09A-3/4"	B	106CP	ASTM A106	B	150	129	90	1.050	80	0.154	1.0"	1.474	0.187	0.52	2.18	0.187	1.661
	30	32	1MC08A-3/4"	D	100	ASTM A106	B	150	129	90	1.050	80	0.154	1.0"	1.474	0.187	0.52	2.18	-	-
	5	15	1MC06B-4"	B	106CP	ASTM A106	B	150	129	90	4.500	40	0.237	1.0"	10.79	5.51	1.40	17.70	5.51	16.3

VALVE & SPECIAL FITTINGS DATA

REV.	NODE POINTS		TYPE	PRESSURE RATING	VAL. STROKING TIME (SEC.)		VAL./FIT. WT. LBS.		OPERATOR WT. LBS.		FLEXIBILITY INFO.		VENDOR	DRAWING NO.	REV.	REMARKS
	FROM	TO			OPEN	CLOSE	PRELIM.	ACTUAL	PRELIM.	ACTUAL	O.D.	THICK				
		15	25	GATE	150				335			4.500	1.185	ANCHOR/DARLING VALVE CO.		-
	35	50A	GATE	150				83			4.500	1.185	CRANE COMPANY		N	1MC008

* INCLUDES OPERATOR

EMD-044235
ADDENDUM: B
PAGE 18

RELEASE RECORD

REV	DATE	PREPARED	CHECKED	ENG'R APP'L	REV. DESCRIPTION	FILM
0	10-17-83	<i>[Signature]</i>	<i>[Signature]</i>	MLC	FOR PMD COMMENTS	
1	11-19-83	<i>[Signature]</i>	<i>[Signature]</i>	<i>[Signature]</i>	FOR ANALYSIS	X
2	11-21-84	<i>[Signature]</i>	<i>[Signature]</i>	<i>[Signature]</i>	UPDATED PIPE & VALVE DATA PER LATEST LINE LIST & VENDOR DATA	

PIPING ANALYTICAL & PHYSICAL DATA
FOR MAKE-UP CONDENSATE STORAGE SYSTEM
PROJECT CLINTON POWER STATION UNIT-1
CLIENT ILLINOIS POWER COMPANY
PROJECT NO. 4536-00

SARGENT & LUNDY
SUBSYSTEM NO. 1MC-04B
REV. 2
SHEET 2 OF 3

FORM M28-6.4.2 APPROVED BY *[Signature]* D.M. 4/87


Client **ILLINOIS POWER COMPANY**
Project **CLINTON - 1**
Proj. No. **4536-00** Equip. No.

Prepared by *[Signature]* Date **12-19-84**
Reviewed by *[Signature]* Date **12-21-84**
Approved by Date

Penetration
IMC-065

ECN 30052 ADDS A RUPTURE DISK
+ RELIEF VALVE ASSEMBLY (218 LBS)
TO IWX12AA-2... PRT/1/24/87
@ NO. 27 1/24/87
SPT SPT

4.0. CALCULATION
4.1. ISOMETRIC LINE DRAWING

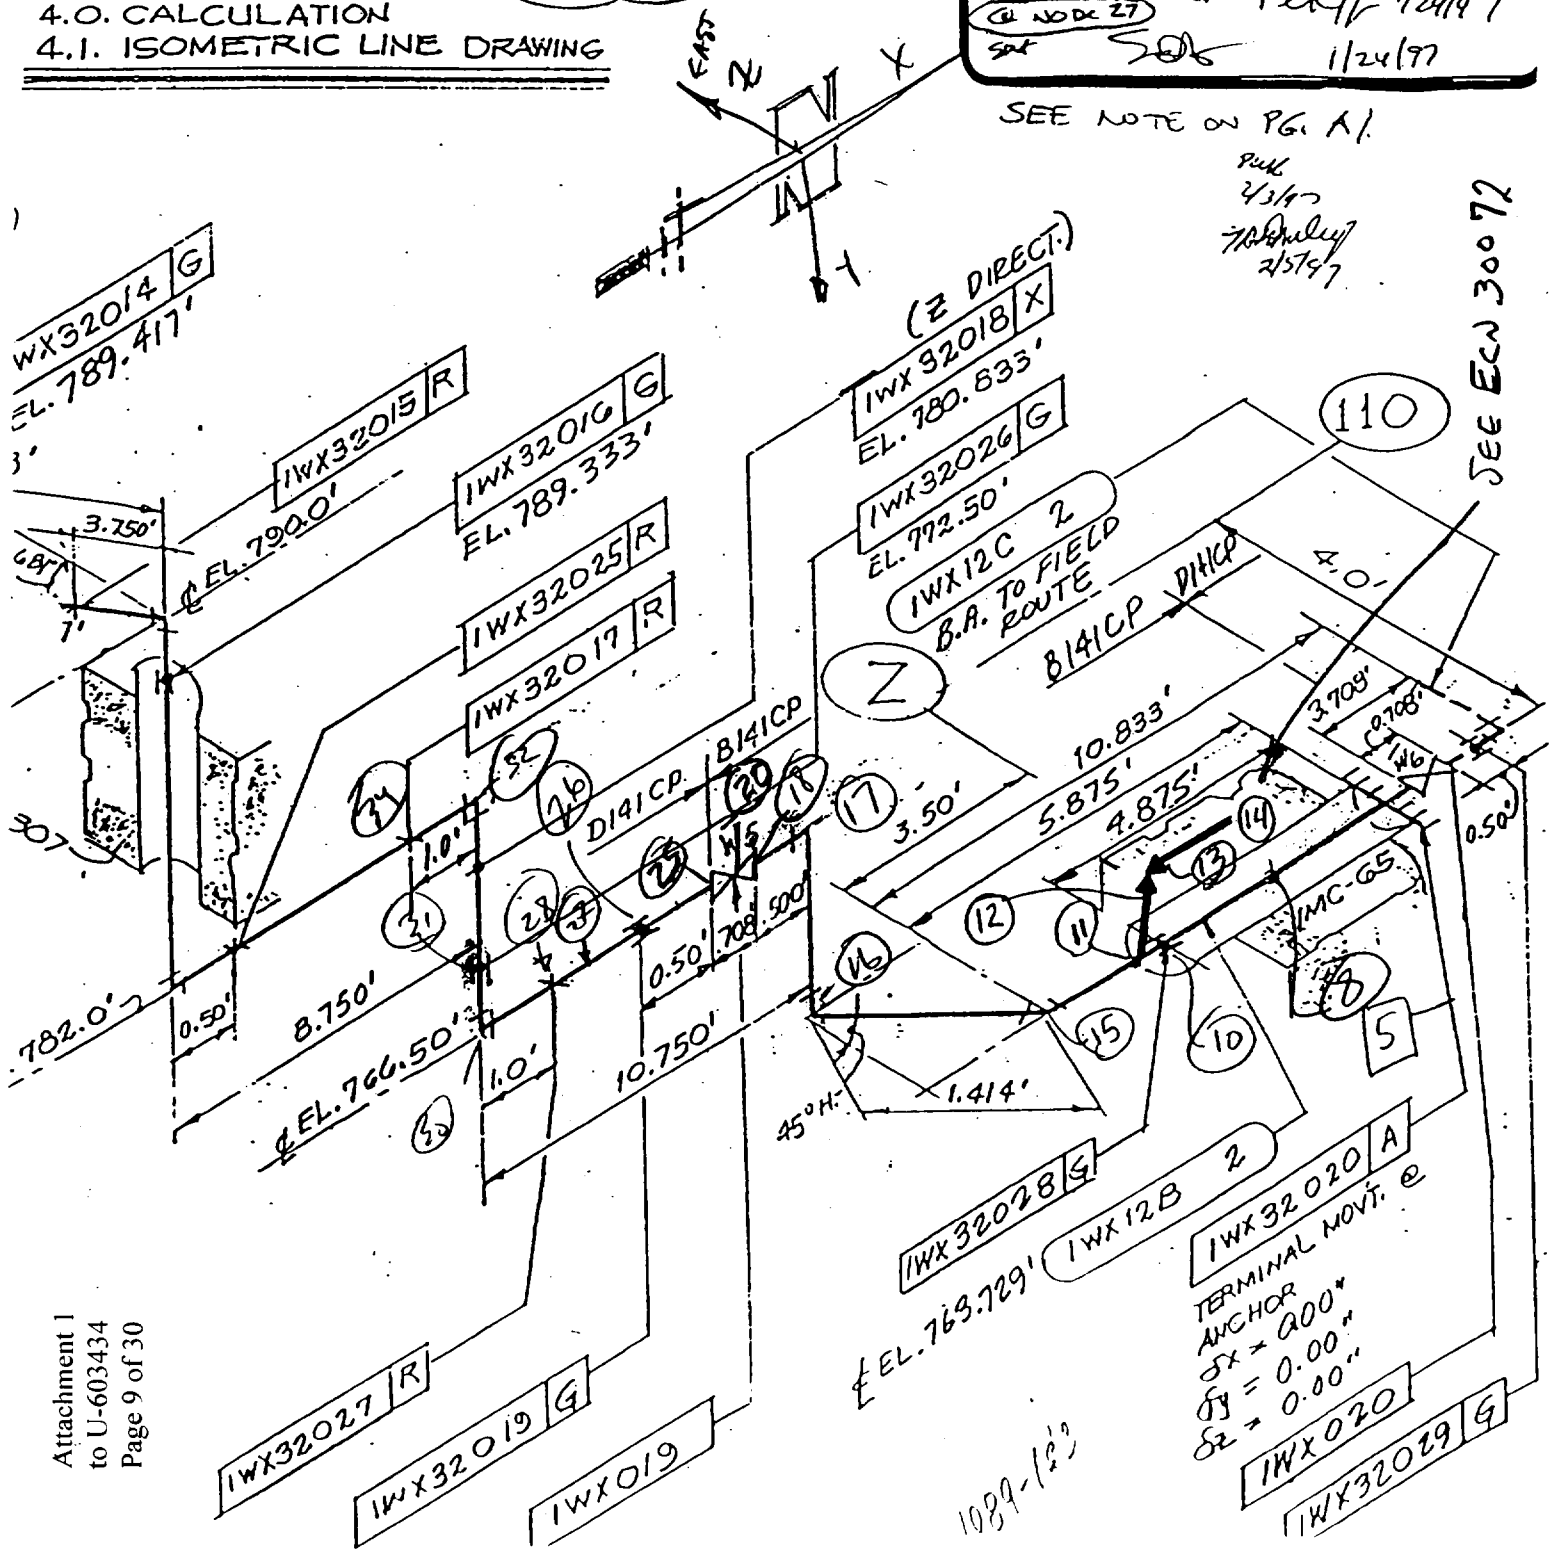


SEE NOTE ON PG. A/

Pub
4/3/87
7/10/87
2/5/87

SEE ECN 30072

EMD-034714
ADDENDUM: A
PAGE 38

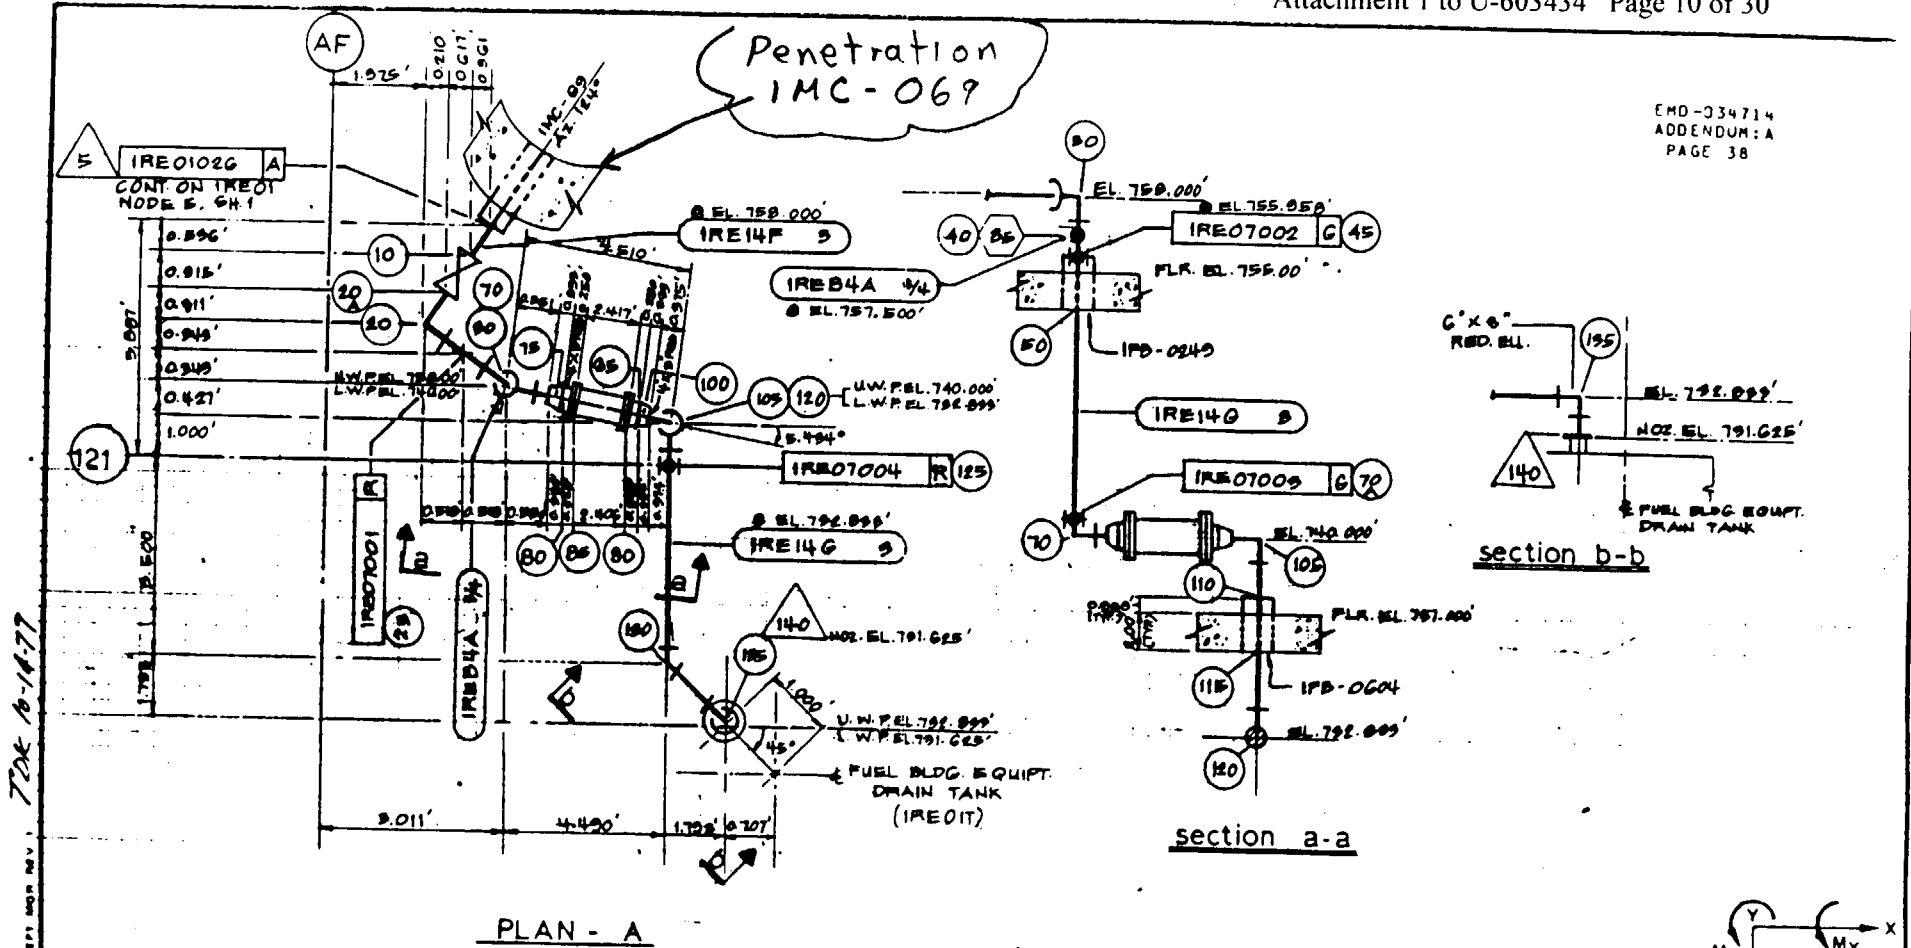

TDX 10-14-77

PLAN - A

REFERENCE DRAWINGS	DWG. NO.	REV.	DWG. NO.	REV.	DWG. NO.	REV.	DWG. NO.	REV.	DWG. NO.	REV.
	MOS-1046-1	D	MOS-1046-1	J						
	MOS-1046-3	C								

RELEASE RECORD						
REV.	DATE	PREPARED	REVIEWED	APPROVED	PURPOSE	FILM
0	12-08-81	<i>Marion A. Gaudin</i>			FOR PMD COMMENTS	
1	12-14-81	<i>Marion A. Gaudin</i>	<i>Jensen</i>	<i>Jensen</i>	INCORP. PMD COMMENTS FOR FORMAL ANALYSIS	X
2	01-18-85	<i>Marion A. Gaudin</i>	<i>Marion A. Gaudin</i>	<i>Marion A. Gaudin</i>	UPDATED PIPE & VALVE DATA FOR EMD EVALUATION.	X

PIPING ANALYTICAL & PHYSICAL DATA
FOR FUEL BLDG. EQUIPT. DRAIN SYSTEM
PROJECT CLINTON 1
CLIENT ILLINOIS POWER CO.
PROJECT NO. 4536-00

NO SCALE

SARGENT & LUNDY
CHICAGO

SUB SYSTEM NO.	REV.
1RE07	2

SHEET 1 OF 3

M-15-14-1110-77 FORM APPROVED BY

Penetration IMC 069

PIPE DATA

REV	NODE POINTS		LINE NUMBER	PIPE CLASS	PIPING DESIGN TABLE	MATERIAL		DESIGN PRESS.	MAX. OPEN.		O.D.	SCHED.	WALL THICK.	INSUL. THICK.	WEIGHTS - LBS./LINEAL FT.					
	FROM	TO				SPEC.	GR.		PRESS.	TEMP.					1. PIPE	2. OPER. FLUID	3. INSUL.	OPER. TOTAL	1+2+3	4. WATER
	5	10	1RE14F 3	B	10GCP	SA-106	B	35	35	150	3.50	40	0.216	N	7.58	3.20	0.00	10.780		
	10	140	1RE14G 3	D	105CP	A-106	B	35	35	150	3.50	40	0.216	N	7.58	3.20	0.00	10.780		
	40	42	1REB4A 34	D	105CP	A-106	B	35	35	150	1.050	80	0.154	N	1.470	0.107	0.00	1.657		

EMD-034714
ADDENDUM: A
PAGE 39

VALVE & SPECIAL FITTINGS DATA

REV	NODE POINTS		TYPE	PRESSURE RATING	VAL. STROKING TIME (SEC.)		VAL./FIT. WT. LBS.		OPERATOR WT. LBS.		FLEXIBILITY INFO.		VENDOR	DRAWING NO.	REMARKS
	FROM	TO			OPEN	CLOSE	PRELIM.	ACTUAL	PRELIM.	ACTUAL	O.D.	THICK.			
	10	60A	CENTRAL VALVE	150							9.50		FISHER CONTROLS	2EAG251	1RE022
	85	90	WATER METER	150				415			4.50		HERSEY PRODUCTS	BP. 761-GM-572	1RE01M
	80	85	R.F.W.N FLANGE	150			15				4.50		GW TAYLOR FORGE		
	90	95	R.F.W.N FLANGE	150			15				4.50		GW TAYLOR FORGE		
	135A	135B	REDUCING ELBOW	150			17				6.025x3.50		CRANE CATALOG		

RELEASE RECORD

REV	DATE	PREPARED	REVIEWED	APPROVED	PURPOSE	FILM
0	12-08-81	Monahan A. Gaudin				
1	12-14-81	Monahan A. Gaudin			FOR PMD COMMENTS INCORP. PMD COMMENTS FOR FORMAL ANALYSIS	X
2	01-18-85	Monahan A. Gaudin			UPDATED PIPE & VALVE DATA FOR EMP EVALUATION.	X

PIPING ANALYTICAL & PHYSICAL DATA	
FOR FUEL BLDG. EQUIPT. DRAIN SYSTEM	
PROJECT CLINTON 1	
CLIENT ILLINOIS POWER CO	
PROJECT NO. 453C-00	

SARGENT & LUNDY
CHICAGO

SUB SYSTEM NO.	REV.
1RE07	2
SHEET 2 OF 3	

TDX 10-14-77

DEPT. MGR. REV. 1 TDX 10-14-77

VE-18-14-2 (10-77) FORM APPROVED BY

Penetration IMC 069

REV.	NODE POINTS		LINE NUMBER	PIPE CLASS	PIPING DESIGN TABLE	MATERIAL		DESIGN PRESS.	MAX. OPER.		O.D.	SCHED.	WALL THICK	INSUL. THICK	WEIGHTS - LBS./LINEAL FT.						
	FROM	TO				SPEC.	GR.		PRESS.	TEMP.					1. PIPE	2. OPER FLUID	3. INSUL.	OPER TOTAL	1+2+3	4. WATER	HYDRO 1+4
	5	25				1RE14F3	B		106 CP	SA 106					B	35	33	150	3.50	40	0.216
25	190	1RE14E3	D	105 CP	A 106	B	35	33	150	3.50	40	0.216	0.0	7.575	3.205	0.0	10.780				
190	240	1RE14D3	B	106 CP	SA 106	B	35	33	150	3.50	40	0.216	0.0	7.575	3.205	0.0	10.780				
70	330	1RE32B3	D	105 CP	A 106	B	35	33	150	3.50	40	0.216	0.0	7.575	3.205	0.0	10.780	3.205	10.78		
470	500	1RE32AA3	D	105 CP	A 106	B	35	33	150	3.50	40	0.216	0.0	7.575	3.205	0.0	10.780				
470	530	1RE32AB3	D	105 CP	A 106	B	35	33	150	3.50	40	0.216	0.0	7.575	3.205	0.0	10.780				
33	35	1REB2A 3/4	D	105CP	A106	B	35	33	150	1.050	80	0.154	0.0	1.470	0.188	0.0	1.658				
27	28	1REB3A 3/4	D	105CP	A106	B	35	33	150	1.050	80	0.154	0.0	1.470	0.188	0.0	1.658				

TO BE ANALYSED PER IRE01A ON LATER DATE

Acc. No.: EMD-044518
Addendum: B
Page 12

REV.	NODE POINTS		TYPE	PRESSURE RATING	VAL. STROKING TIME (SEC.)		VAL./FIT. WT. LBS.		OPERATOR WT. LBS.		FLEXIBILITY INFO.		VENDOR	DRAWING NO.	REV.	REMARKS
	FROM	TO			OPEN	CLOSE	PRELIM.	ACTUAL	PRELIM.	ACTUAL	O.D.	THICK				
	15B	25			C.V.	150				260						
37	43	GATE	150				62						CRANE	K-6738	N	1RE030
190	200A	C.V.	150				260						FISHER CONTROLS	35A6351	B	1RE020
475B	485	GATE	150				62						CRANE	K-6738		1RE039A
490	495	N.CHECK	150				42						CRANE	FB-154143		1RE038A
500	505	FLANGE	150			10							CRANE CATALOGUE			3" W.N.
510B	520	GATE	150				62						CRANE CONTROLS	K-6738		1RE039B
525	530	N.CHECK	150				42						CRANE	FB-154143		1RE038B
535	540	FLANGE	150			10							CRANE CATALOGUE			3" W.N.
485	490	FLANGE	150			10							CRANE			
520	525	FLANGE	150			10							CRANE			


TO BE ANALYSED PER IRE01A ON LATER DATE

MS-1514 IS IN FORM APPROVED BY DEPT. OF...

RELEASE RECORD						PIPING ANALYTICAL & PHYSICAL DATA			SARGENT & LUNDY		
REV	DATE	PREPARED	CHECKED	ENG'R APP'L	REV. DESCRIPTION	FILM	FOR	PROJECT	CLIENT	SUB SYSTEM NO.	REV.
0	12-08-78				PRELIMINARY		EQUIPMENT DRAIN SYSTEM	CLINTON UNIT-1	ILLINOIS POWER CO.	1RE01	2
1	03-14-81	A. Daniel	Marcus	R.W. Evans	FOR FORMAL ANALYSIS						
2	05-27-84	Y Chan	Margaret	J. Hovick	UPDATED PER END STRESS REPORT NO. 044518						

4536

SHEET 4 OF 5

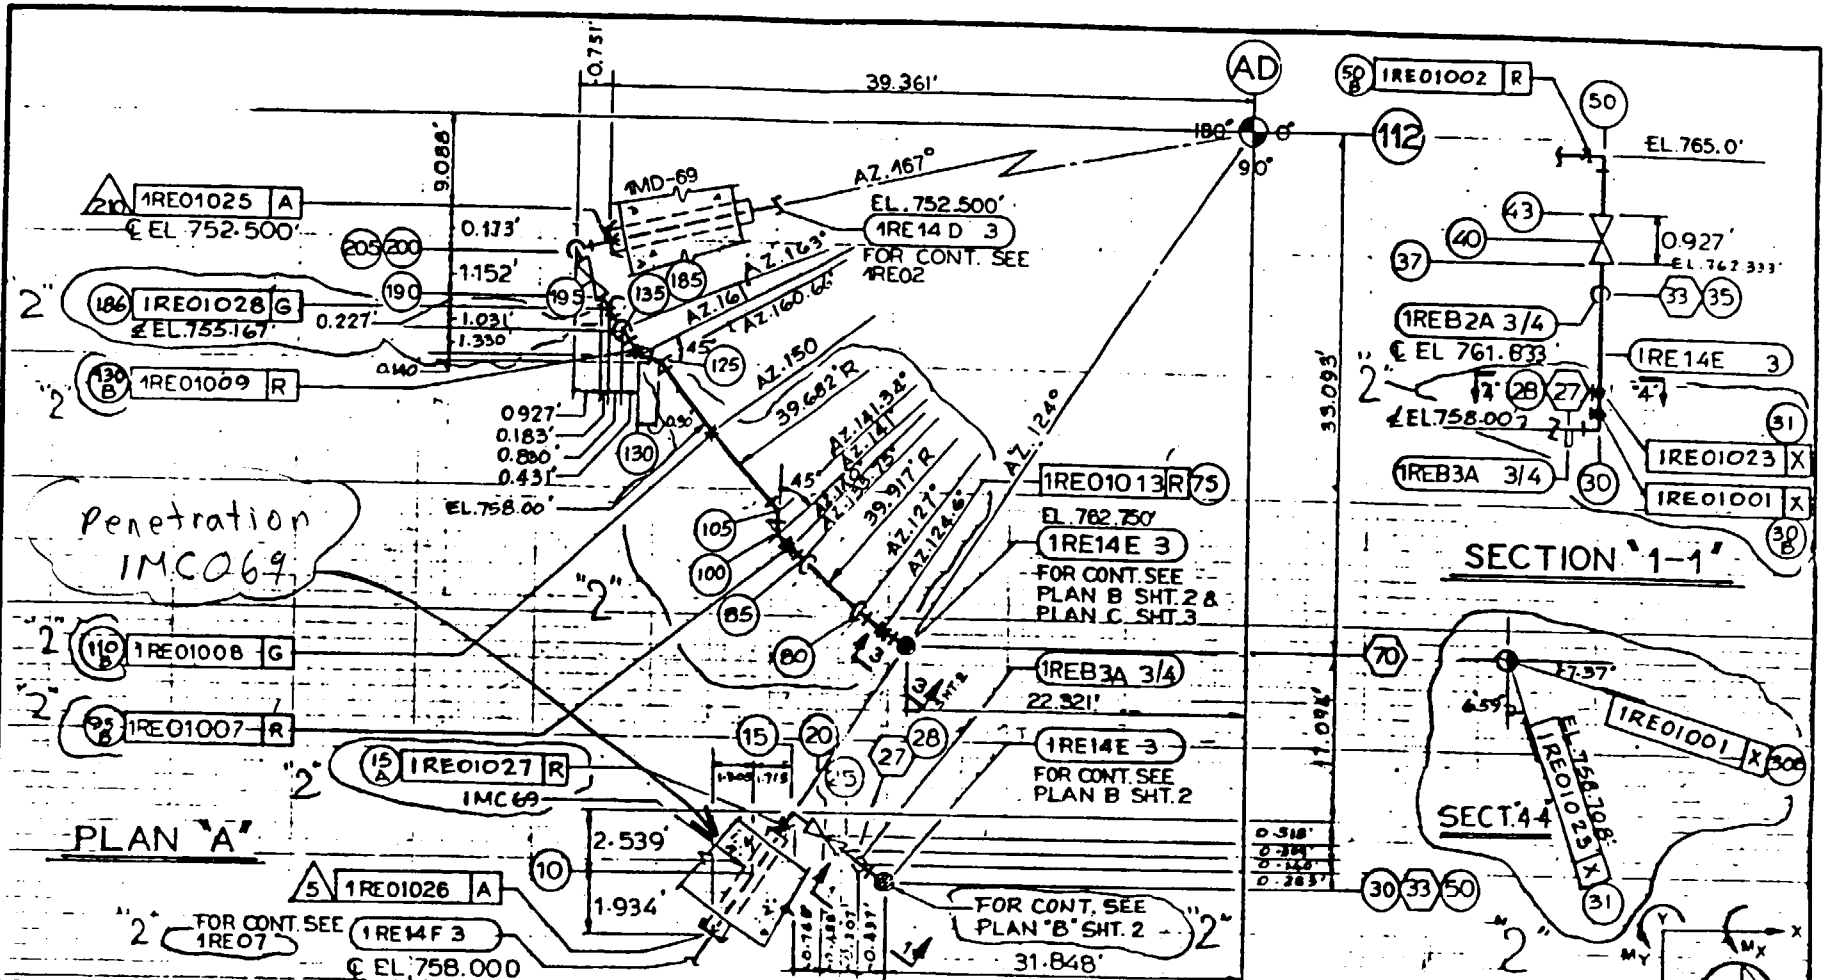

11/15/81 11:15 AM FROM APPROVED BY TDE 10-14-77

REFERENCE DRAWINGS	DWG. NO.	REV.	DWG. NO.	REV.	DWG. NO.	REV.	DWG. NO.	REV.	DWG. NO.	REV.
	M05-1046-3	D	M06-1046-7	(K)	2					
	M27-1002-03A	D								

Acc. No.: EMD-04451R
 Addendum: B
 Page 9

RELEASE RECORD					
REV.	DATE	PREPARED	REVIEWED	APPROVED	PURPOSE
0	12-08-78	<i>Adrian Kraf</i>			PRELIMINARY
1	03-14-81	<i>D. W. Dant</i>	<i>M. L. Conner</i>	<i>R. W. Egan</i>	FOR FORMAL ANALYSIS
2	05-27-84	<i>J. Chan</i>	<i>M. L. Conner</i>	<i>G. M. Meka</i>	UPDATED PER EM STRESS REPORT NO. 2444

PIPING ANALYTICAL & PHYSICAL DATA EQUIPMENT DRAIN SYSTEM		
FOR PROJECT	CLINTON UNIT-1	
CLIENT	ILLINOIS POWER CO.	SUB SYSTEM NO. - REV. 1RE01 - 2
PROJECT NO.	4536	SHEET 1 OF 5

Penetration IMC 069

REV.	NODE POINTS		LINE NUMBER	PIPE CLASS	PIPING DESIGN TABLE	MATERIAL		DESIGN PRESS.	MAX. OPER.		O.D.	SCHED.	WALL THICK	INSUL. THICK	WEIGHTS - LBS./LINEAL FT.						
	FROM	TO				SPEC.	GR.		PRESS.	TEMP.					1. PIPE	2. OPER FLUID	3. INSUL.	OPER TOTAL	1+2+3	4. WATER	HYDRO 1+4
	5	25				1RE14F3	B		106 CP	SA 106					B	35	33	150	3.50	40	0.216
25	190	1RE14E3	D	105 CP	A 106	B	35	33	150	3.50	40	0.216	0.0	7.575	3.205	0.0	10.780				
190	240	1RE14D3	B	106 CP	SA 106	B	35	33	150	3.50	40	0.216	0.0	7.575	3.205	0.0	10.780				
70	330	1RE32B3	D	105 CP	A 106	B	35	33	150	3.50	40	0.216	0.0	7.575	3.205	0.0	10.780	3.205	10.78		
470	500	1RE32AA3	D	105 CP	A 106	B	35	33	150	3.50	40	0.216	0.0	7.575	3.205	0.0	10.780				
470	530	1RE32AB3	D	105 CP	A 106	B	35	33	150	3.50	40	0.216	0.0	7.575	3.205	0.0	10.780				
33	35	1REB2A 3/4	D	105CP	A106	B	35	33	150	1.050	80	0.154	0.0	1.470	0.188	0.0	1.658				
27	28	1REB3A 3/4	D	105CP	A106	B	35	33	150	1.050	80	0.154	0.0	1.470	0.188	0.0	1.658				

TO BE ANALYSED PER IREOIA ON LATER DATE

Acc. No.: EMD-044518
Addendum: B
Page 12


REV.	NODE POINTS		TYPE	PRESSURE RATING	VAL. STROKING TIME (SEC.)		VAL./FIT. WT. LBS.		OPERATOR WT. LBS.		FLEXIBILITY INFO.		VENDOR	DRAWING NO.	REV.	REMARKS
	FROM	TO			OPEN	CLOSE	PRELIM.	ACTUAL	PRELIM.	ACTUAL	O.D.	THICK				
	15B	25			C.V.	150				260						
37	43	GATE	150				62				3.500		CRANE	K-678B	N	1RE030
190	200A	C.V.	150				260						FISHER CONTROLS	35A6351	B	1RE020
475B	485	GATE	150				62						CRANE	K-678B		1RE039A
490	495	N.CHECK	150				42						CRANE	FB-18A143		1RE038A
500	505	FLANGE	150			10							CRANE CATALOGUE			3" W.N.
510B	520	GATE	150				62						CRANE CONTROLS	K-678B		1RE039B
525	530	N.CHECK	150				42						CRANE	FB-18A143		1RE038B
535	540	FLANGE	150			10							CRANE CATALOGUE			3" W.N.
485	490	FLANGE	150			10							CRANE			
520	525	FLANGE	150			10							CRANE			

TO BE ANALYSED PER IREOIA ON LATER DATE

35-18-142 19 TELEFORM APPROVED BY DEPT MGR

RELEASE RECORD						PIPING ANALYTICAL & PHYSICAL DATA			SARGENT & LUNDY		
REV.	DATE	PREPARED	CHECKED	ENG'R APP'L	REV. DESCRIPTION	FILM	FOR	PROJECT	CLIENT	SUB SYSTEM NO.	REV.
0	12-08-78				PRELIMINARY		EQUIPMENT DRAIN SYSTEM	CLINTON UNIT-1	ILLINOIS POWER CO.	1RE01	
1	03-14-81	A. Daniel	M. Brown	P.W. Egan	FOR FORMAL ANALYSIS						
2	05-27-84	Y Chan	M. Brown	J. H. ...	UPDATED PER EMD STRESS REPORT NO. 044518						
							PROJECT NO.				
							4536				

SARGENT & LUNDY
CHICAGO
SUB SYSTEM NO. 1RE01
REV. 2
SHEET 4 OF 5

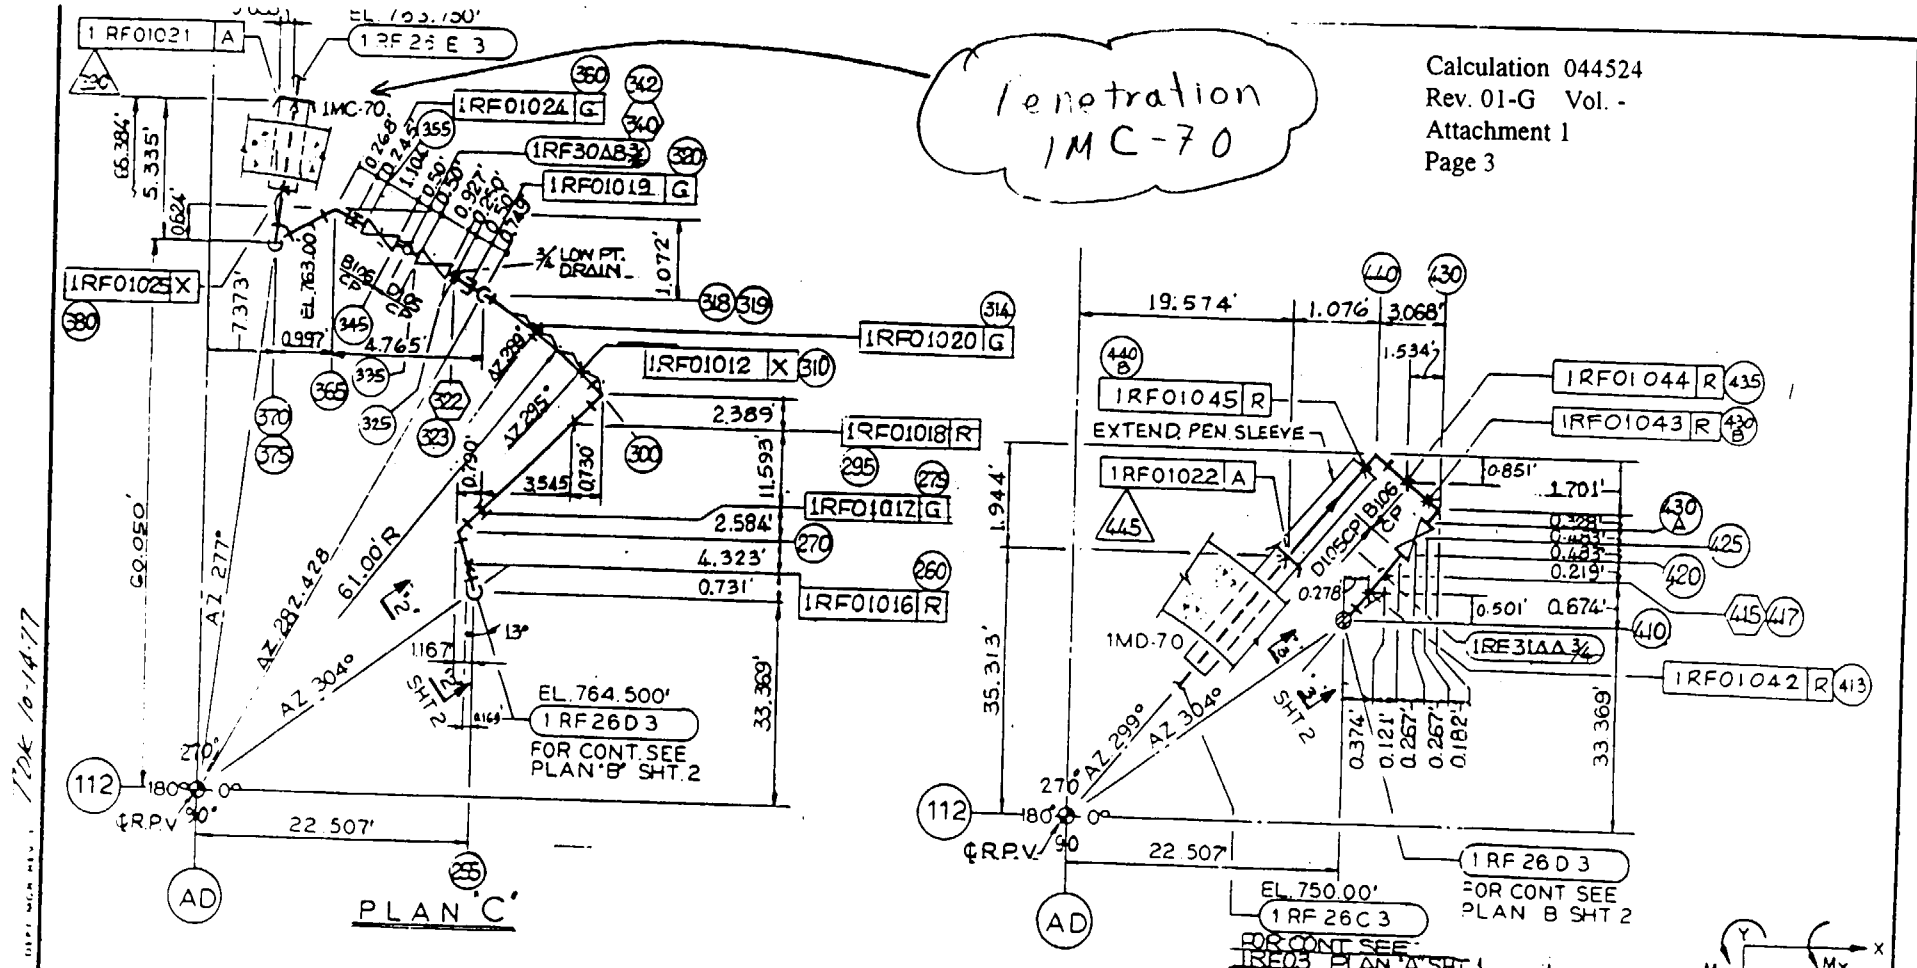

REFERENCE DRAWINGS	DWG. NO.	REV.	DWG. NO.	REV.	DWG. NO.	REV.	DWG. NO.	REV.	DWG. NO.	REV.
	M05-1047-3	C	2							
	M06-1047-7	T								

RELEASE RECORD						
REV.	DATE	PREPARED	REVIEWED	APPROVED	PURPOSE	FILM
0	02-24-81	A. Williams			FOR COMMENTS	
1	03-12-81	A. Williams	M. ...	R. ...	FOR ANALYSIS	
2	03-19-84	Y. Chan	M. ...	J. ...	UPDATE PER STRESS REPORT NO. EMP-044524 REV. 01	
3	02-17-85	A. ...	J. ...	J. ...	UPDATED PIPE & VALVE DATA FOR RMP EVALUATION	

NO SCALE

PIPING ANALYTICAL & PHYSICAL DATA
FOR CONTAINMENT BLDG. FLOOR DRAIN SYSTEM

PROJECT **CLINTON UNIT-1**


CLIENT **ILLINOIS POWER CO.**

PROJECT NO. 4536

SARGENT & LUNDY
INCORPORATED CHICAGO

SUB SYSTEM NO.	REV.
1RFO1	3

SHEET. 3 OF 5

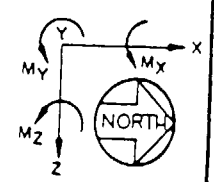

Penetration IMC-70

REV.	NODE POINTS		LINE NUMBER	PIPE CLASS	PIPING DESIGN TABLE	MATERIAL		DESIGN PRESS.	MAX. OPER.		O.D.	SCHED.	WALL THICK	INSUL. THICK	WEIGHTS - LBS./LINEAL FT.							
	FROM	TO				SPEC.	GR.		PRESS.	TEMP.					1. PIPE		2. OPER. FLUID	3. INSUL.	OPER. TOTAL	1-2+3	4. WATER	HYDRO 1+4
	35	62	1RF29AA3	D	105CP	ASTM A-106	B	35	32	150	3.500	40	0.216	0.0	7.58	3.20	0.0	10.78				
	5	62	1RF29AB3	D	105CP	ASTM A-106	B	35	32	150	3.500	40	0.216	0.0	7.58	3.20	0.0	10.78				
	62	245	1RF29B3	D	105CP	ASTM A-106	B	35	32	150	3.500	40	0.216	0.0	7.58	3.20	0.0	10.78				
	345	390	1RF26D3	D	105CP	ASTM A-106	B	35	32	150	3.500	40	0.216	0.0	7.58	3.20	0.0	10.78				
	420	445	1RF26E3	B	106CP	ASTM A-106	B	35	32	150	3.500	40	0.216	0.0	7.58	3.20	0.0	10.78				
	7	8	1RF29DA3/4	D	105CP	ASTM A-106	B	35	32	150	3.500	40	0.216	0.0	7.58	3.20	0.0	10.78	3.20	10.78		
	37	38	1RF29CA3/4	D	105CP	ASTM A-106	B	35	32	150	1.050	80	0.154	0.0	1.47	0.19	0.0	1.66	3.20	10.78		
	340	342	1RF30AB3/4	D	105CP	ASTM A-106	B	35	32	150	1.050	80	0.154	0.0	1.47	0.19	0.0	1.66				
	415	417	1RF31AA3/4	D	105CP	ASTM A-106	B	35	32	150	1.050	80	0.154	0.0	1.47	0.19	0.0	1.66				

Calculation 044524

Rev. 01-G Vol. -

Attachment 1

Page 4

REV.	NODE POINTS		TYPE	PRESSURE RATING	VAL. STROKING TIME (SEC.)		VAL./FIT. WT. LBS.		OPERATOR WT. LBS.		FLEXIBILITY INFO.		VENDOR	DRAWING NO.	REV.	REMARKS
	FROM	TO			OPEN	CLOSE	PRELIM.	ACTUAL	PRELIM.	ACTUAL	O.D.	THICK				
	5	6	FLANGE	150			10.00									
	10	15	CHECK	150							3.50		CRANE CAT.			
	20	30A	GATE	150			56.00				3.50		CRANE	K-8931-I	I	3" F.F.W.N.
	35	36	FLANGE	150			62.00				3.50		CRANE	K-6738-N	N	1RF027B, K-12865A
	40	45	CHECK	150							3.50		CRANE	K-6738-N	N	1RF028B, K-12865A
	50	55A	GATE	150			56.00				3.50		CRANE CAT.			3" F.F.W.N.
	325	335	GATE	150			62.00				3.50		CRANE	K-8931-I	I	1RF027A, K-12865A
	345	355	C.V.	150			62.00				3.50		CRANE	K-6738-N	N	1RF028A, K-12865A
	420	430A	C.V.	150			260.00				3.50		CRANE	K-6738-N	N	1RF025, K-12865A
	15	20	FLANGES	150			20.00				3.50		FISHER	35A6351	C	1RF021, K-12864
	45	50	FLANGES	150			20.00				3.50		FISHER	35A6351	C	1RF020, K-12864
	401	402	FLANGE	150			8.00				3.50		CRANE CAT.			3" R.F.W.N.
	402	404	INSTR.	N/A			15.20				3.50		CRANE CAT.			3" R.F.W.N.
	404	405	FLANGE	150			8.00				3.50		NAVCO DATALOG			3" F.F.S.O.
											3.50		YOKOGAWA ELEC. CORP.	CAT. GS1E600-E	8 TH	1E31-N761
											3.50		NAVCO DATALOG			3" F.F.S.O.

ADDED IN ADDENDA G * WEIGHTS INCLUDED 2 MATCHING FLANGES.

REV. 15.14.12 SYSTEM APPROVED



REV.	DATE	PREPARED	CHECKED	ENG'R APPL.	REV. DESCRIPTION	FILM
0	02-26-81	L. Williams				
1	03-12-81	L. Williams	M. Anderson	R.W. Evans	FOR COMMENTS	
2	03-19-84	J. Chan	M. Anderson	J. Anderson	FOR ANALYSIS	XX
3	02-17-85	M. Anderson	J. Anderson	J. Anderson	UPDATED PER STRESS REPORT NO. EMP. 044524 REV. 01	

PIPING ANALYTICAL & PHYSICAL DATA
 FOR CONTAINMENT BLDG. FLOOR DRAIN SYSTEM
 PROJECT CLINTON UNIT-1
 CLIENT ILLINOIS POWER CO.
 PROJECT NO.


SARGENT & LUNDY
 ENGINEERS
 CHICAGO

SUB SYSTEM NO. 1RF01
 REV. 3

Form IREB-MOD-4.1 Approved by *[Signature]* Date *[Date]*
 Per Orig (2-23-83)

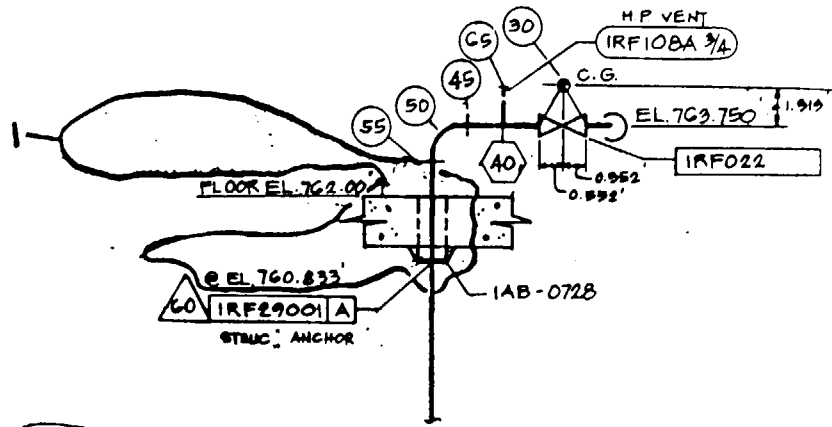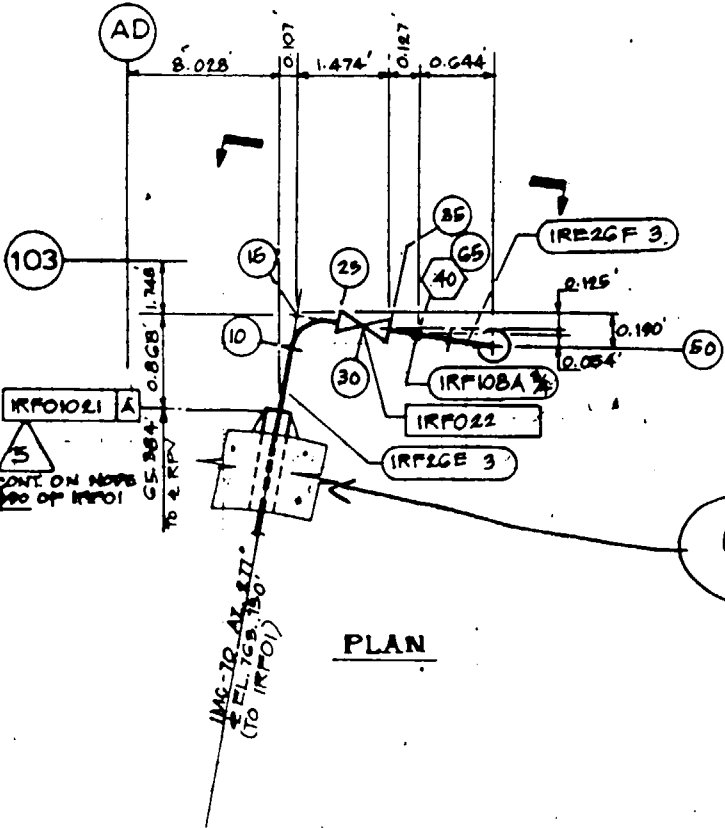

PROJ. NO.: 4536-10
 ACC. NO.: EML-145357
 CALC. NO.: 19F-29
 REV.: 00
 PAGE 13 OF 16

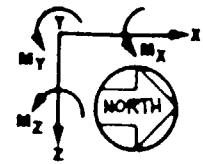

REFERENCE DRAWINGS	DWG NO	REV.	DWG. NO.	REV.	DWG. NO.	REV.	DWG. NO.	REV.	DWG. NO.	REV.
	MOF-1047-3	D	SRG-1001-MA	L	MOB-1117-10	L				
	MOG-1047-3	J	MOG-1047-A	L						

REVISION RECORD						
REV	DATE	PREPARED	REVIEWED	APPROVED	PURPOSE	FILM
0	05.08.84	<i>[Signature]</i>	<i>[Signature]</i>	<i>[Signature]</i>	FOR FORMAL ANALYSIS	X
1	01-10-85	<i>[Signature]</i>	<i>[Signature]</i>	<i>[Signature]</i>	REVISION FOR USE WITH 855 REPORT 82487950 / 2. REPORTER VALUE INTO THE NEW DRAWING ICH.	✓

ANALYTICAL DRAWING: ORTHOGONAL SHEET

FOR CONTAINMENT FLOOR DRAIN SYSTEM

PROJECT CLINTON-1

CLIENT ILLINOIS POWER CO.

PROJECT NO. 4536-00

NO SCALE

SARGENT & LUNDY

SUBSYSTEM NO.	REV.
1RF29	1

SHEET 1 OF 3

Penetration 1MCO70


PIPE DATA																				
REV.	NODE POINTS		LINE NUMBER	PIPE CLASS	PIPING DESIGN TABLE	MATERIAL		DESIGN PRESS.	MAX. OPER.		O.D.	SCHED.	WALL THICK	INSUL THICK	WEIGHTS - LBS/LINEAL FT					
	FROM	TO				SPEC.	GR.		PRESS.	TEMP.					1. PIPE	2. OPER FLUID	3. INSUL.	OPER TOTAL 1+2+3	4. WATER	HYDRO 1+4
		5	25	1RF2GE 3	B	10GCP	ASTM A106	B	35	32	150	3.50	40	0.216	N	7.58	3.200	0.00	10.78	3.20
	35	60	1RF2GF 3	D	105CP	ASTM A106	B	25	32	150	3.50	40	0.216	N	7.58	3.200	0.00	10.78	0.00	0.00
	40	65	1RF10BA 3/4	D	"	"	"	"	"	"	1.050	80	0.154	N	1.47	0.188	0.00	1.658	0.00	0.00

VALVE & SPECIAL FITTINGS DATA															
REV.	NODE POINTS		TYPE	PRESSURE RATING	VAL. STROKING TIME (SEC.)		VAL./FIT. WT. LBS.		OPERATOR WT. LBS.		FLEXIBILITY INFO.		VENDOR	DRAWING NO.	REMARKS
	FROM	TO			OPEN	CLOSE	PRELIM.	ACTUAL	PRELIM.	ACTUAL	O.D.	THICK			
		29	35	CONTROL VALVE	150				260			3.50	1.080	FISHER CONTROLS	35AG351

PROJ. NO.: 4536-00
 ACC. NO.: EMD-044130
 CALC. NO.: 10F-23
 REV. 01
 PAGE 14 OF 16

FORM MEB-6.4.2 Approved by *[Signature]* D.P.R. M.F.

RELEASE RECORD						PIPING ANALYTICAL & PHYSICAL DATA			SARGENT & LUNDY	
REV	DATE	PREPARED	CHECKED	ENGR APPL	REV DESCRIPTION	FILM	FOR CONTAINMENT FLOOR DRAIN SYSTEM		SUB SYSTEM NO.	REV
0	05.08.84	<i>[Signature]</i>	<i>[Signature]</i>	<i>[Signature]</i>	FOR FORMAL ANALYSIS	X	PROJECT CLINTON 1		1RF29	1
1	01.10.85	<i>[Signature]</i>	<i>[Signature]</i>	<i>[Signature]</i>	REVISED FOR WAP SYSTEM REPORT # 028350 / 2. UPDATED VALVE DATA FOR EMD EVALUATION	X	CLIENT ILLINOIS POWER CO.		4536-00	SHEET 2 OF 3

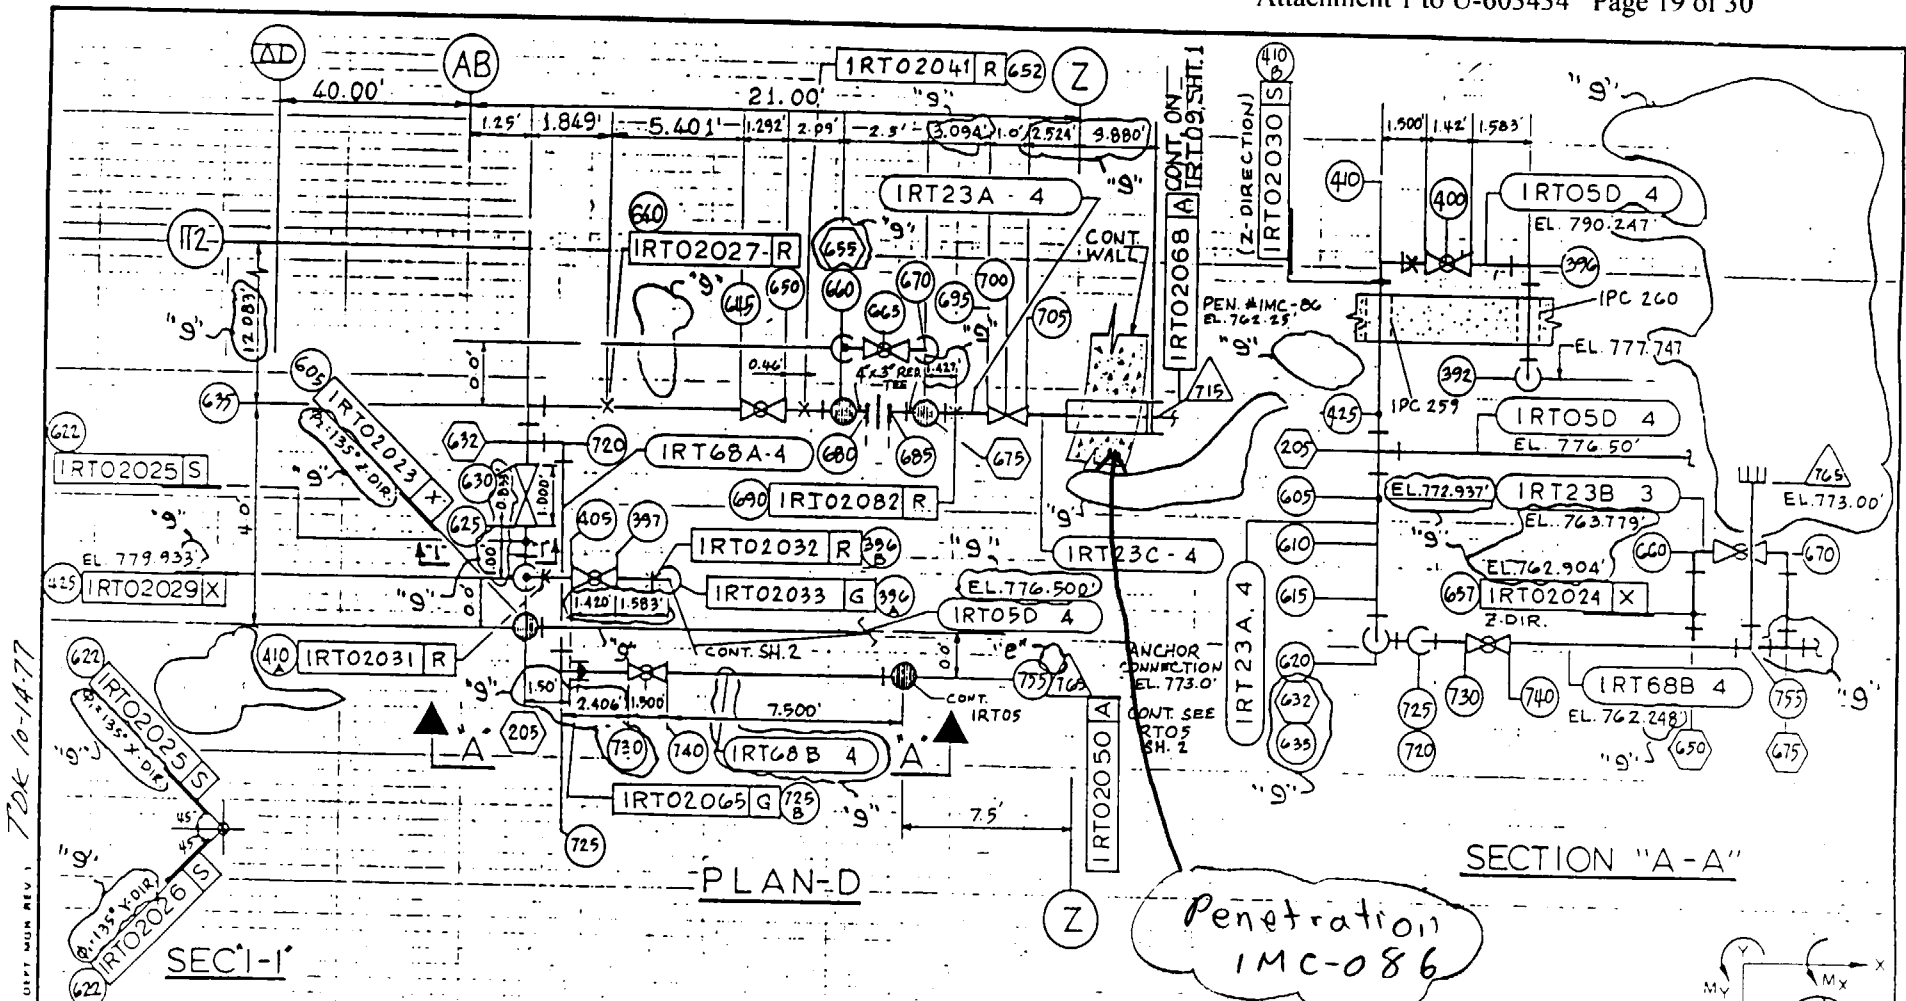

TDC 10-14-77


USP. WORK REV. 1
APPROVED BY

EMD-052792
ADDENDUM C
PAGE 33

REFERENCE DRAWINGS	DWG. NO.	REV.	DWG. NO.	REV.	DWG. NO.	REV.	DWG. NO.	REV.	DWG. NO.	REV.
	M05-1076-1	E	M06-1076-2	E	M06-1076-15	E	M06-1076-16	D		

RELEASE RECORD						
REV	DATE	PREPARED	REVIEWED	APPROVED	PURPOSE	FILM
6	10-10-79	<i>P. Q. Johnson</i>	<i>Quinn</i>	<i>M. J. Johnson</i>		X
7	10-09-84	<i>Rosina Perol</i>	<i>H. Battelle</i>	<i>J. M. Johnson</i>	UPDATED W/ METALLIC INSUL. FOR EMD EVALUATION.	
8	01-11-85	<i>U. H. W. W. W.</i>	<i>J. Battelle</i>	<i>J. M. Johnson</i>	UPDATED PIPE & VALVE DATA FOR EMD EVALUATION.	X
9	11-18-85	<i>J. Battelle</i>	<i>J. Battelle</i>	<i>J. Battelle</i>	UPDATED PER DIT-CP-EMD-1035-3.	X

PIPING ANALYTICAL & PHYSICAL DATA
FOR REACTOR WATER CLEAN-UP SYSTEM
PROJECT CLINTON - I
CLIENT ILLINOIS POWER COMPANY
PROJECT NO. 4536

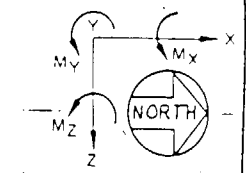

NO SCALE

SARGENT & LUNDY ENGINEERS CHICAGO	
SUB SYSTEM NO.	REV
IRTO2	9
SHEET 4 OF 9	

Penetration 114C-086


REV	NODE POINTS		LINE NUMBER	PIPE CLASS	PIPING DESIGN TABLE	MATERIAL		DESIGN PRESS.	MAX. OPER.		O.D.	SCHED.	WALL THICK	INSUL. THICK	WEIGHTS - LBS/LINEAL FT.						
	FROM	TO				SPEC.	GR.		PRESS.	TEMP.					1. PIPE	2. OPER FLUID	3. INSUL.	OPER TOTAL	1+2+3	4. WATER	HYDRO 1-4
		5				65	IRT05FA 6		C	607CP					SA-106	B	1410	1141	120	6.625	120
9	65	95	IRT05EA 4	.		"	"	"	"	"	4.5		0.438		36.39	10.30	0.00	46.69	10.30	46.69	
	205	N215	IRT05D 4	.		"	"	"	"	"					18.96	4.48	"	23.44	4.48	23.44	
	210	280	IRT04AA 4	.		"	"	"	1208	"											
9	280	N415	IRT04B 4	C	607CP	SA-106	B	1410	1208	120	4.50	120	0.438	0.00							
	205	293	IRT05D 4	.		"	"	"	1141	"					18.96	4.48	0.00	23.44	4.48	23.44	
9	280	483	IRT04AB 4	C	607CP	SA106	B	1410	1208	120	4.50	120	0.438	0.00	18.96	4.48	0.00	23.44	4.48	23.44	
	490	575	IRT05FB 6	C	607CP	SA106	B	1410	1141	120	6.625	120	0.562	0.00							
9	575	175	IRT05EB 4	C	607CP	"	"	"	"	"	4.5	"	0.438	0.00	36.39	10.30	0.00	46.69	10.30	46.69	
	205	695	IRT23A 4	C	607CP	"	"	"	"	"	4.5	120	0.438	0.00	18.96	4.48	0.00	23.44	4.48	23.44	

REV	NODE POINTS		TYPE	PRESSURE RATING	VAL STROKING TIME (SEC.)		VAL/FIT. WT. LBS.		OPERATOR WT. LBS.		FLEXIBILITY INFO.		VENDOR	DRAWING NO.	REV.	VALVE REMARKS/NO.
	FROM	TO			OPEN	CLOSE	PRELIM.	ACTUAL	PRELIM.	ACTUAL	O.D.	THICK				
		65B			70	GATE	600									
	241	245	GATE	600							4.5	2.19	ANCHOR/DARLING CO.	W7820022	A	IG33F304A
9	397	405	MOGLOBE	600							"	"	"	93-14683	B	IG33F303A
	445	446	GATE	600							"	"	"	W7820096		IG33F044
	575B	580	GATE	600							"	"	"	93-14683	B	IG33F303B
	625	630	GATE	600							"	"	"	W7820022	A	IG33F304B
	645	650	CONTROL	600							"	"	"	"		IG33F032
	660B	670A	MOGLOBE	600							3.5	"	ACF INDUSTRIES	VPF NO. 3736-62		IG33F033
	680	685	FLANGES	600			100.8*				4.5	"	ANCHOR/DARLING CO.	W7820097	B	IG33F031
													FLUIDIC TECHNIQUES INC.	S-NP-1021	B	IG33D001
	695	705	M.O GATE	600							"	"				
	730	740	M.O.GLOBE	900							4.5	2.19	ANCHOR/DARLING CO.	93-15094		IG33F028
													ANCHOR/DARLING CO.	93-14696	B	IG33F107

* INCLUDES WT. OF 2 FLANGES

RELEASE RECORD						PIPING ANALYTICAL & PHYSICAL DATA FOR REACTOR WATER CLEAN-UP SYSTEM		SARGENT & LUNDY ENGINEERS CHICAGO	
REV	DATE	PREPARED	CHECKED	ENG'R APP'L	REV. DESCRIPTION	FILM	PROJECT	CLIENT	SUB SYSTEM NO. / REV.
6	10-10-79	<i>[Signature]</i>	<i>[Signature]</i>	<i>[Signature]</i>		X	CLINTON - 1	ILLINOIS POWER COMPANY	IRT02
7	10-09-84	<i>[Signature]</i>	<i>[Signature]</i>	<i>[Signature]</i>	UPDATED WT. OF METALLIC INSUL. FOR EMD EVALUATION.				
8	01-11-85	<i>[Signature]</i>	<i>[Signature]</i>	<i>[Signature]</i>	UPDATED PIPE & VALVE DATA FOR EMD EVALUATION.	X			
9	11-18-85	<i>[Signature]</i>	<i>[Signature]</i>	<i>[Signature]</i>	UPDATED PER DIT-CP-EMD-1035-3.	X			
						PROJECT NO. 4536		SHEET 6 OF 9	

EMD-052792 ADDENDUM C

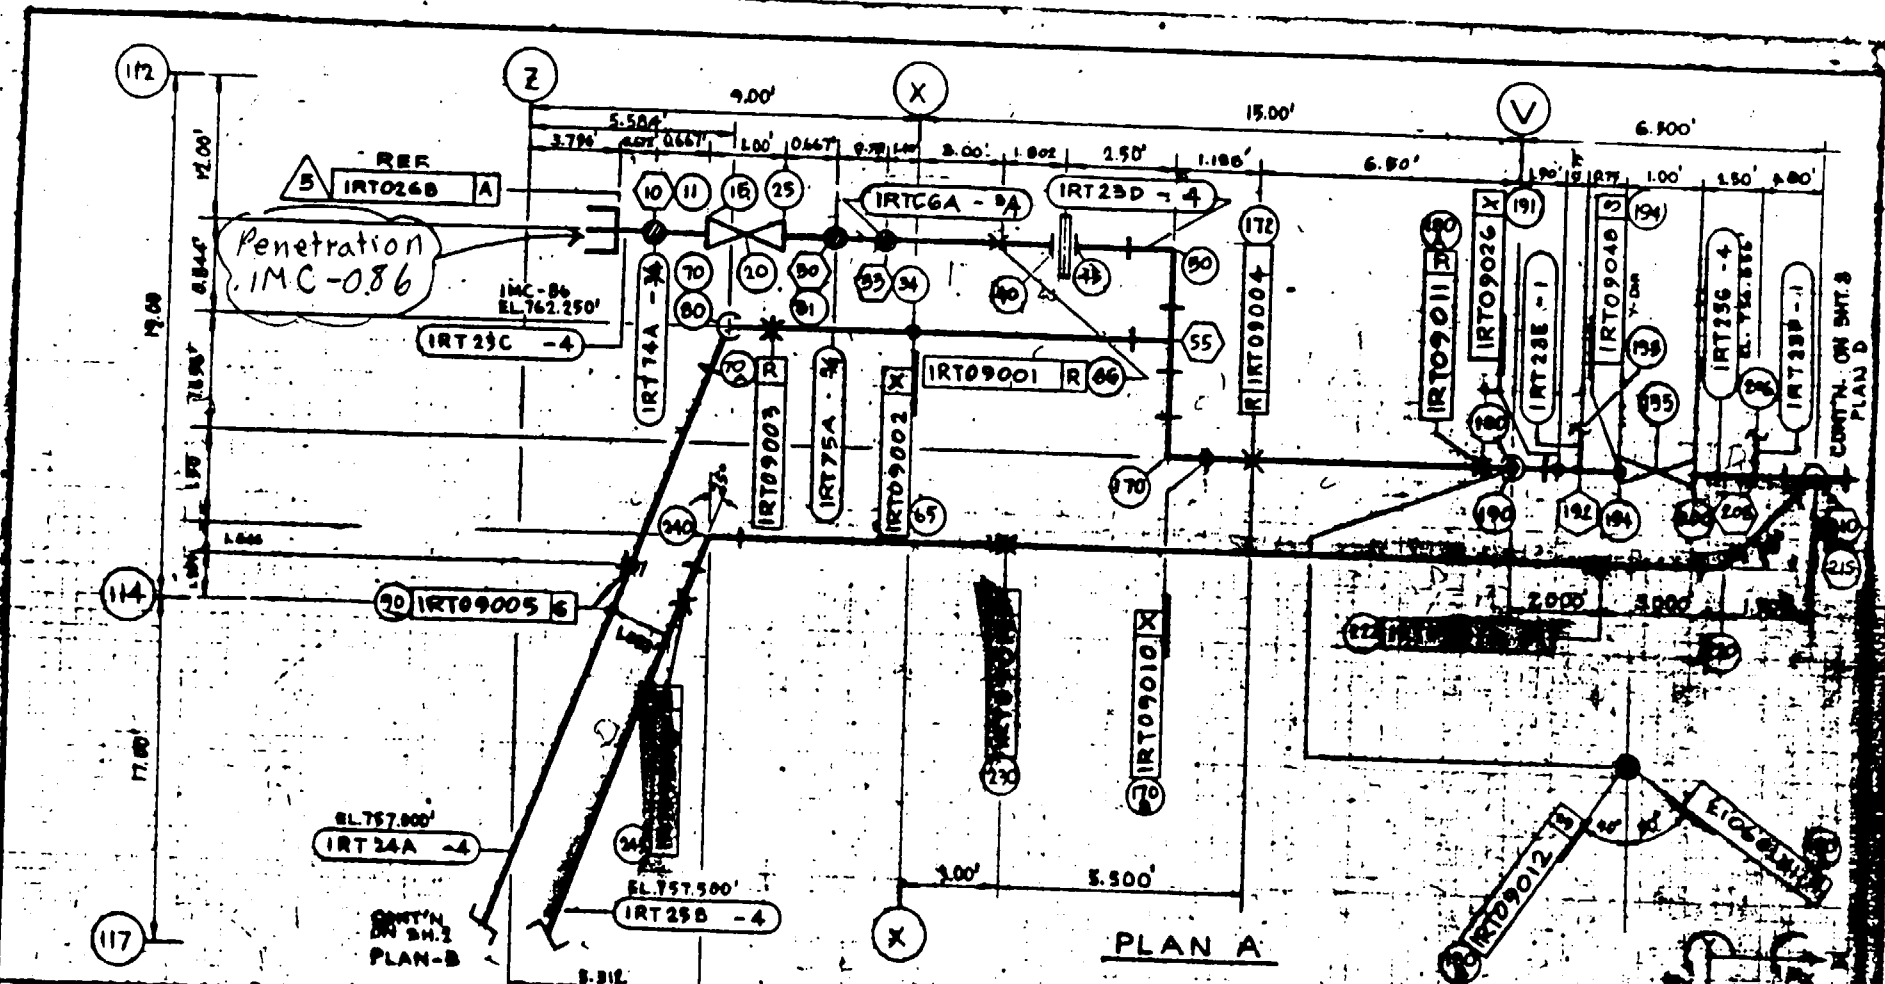

RELEASE RECORD						
REV.	DATE	PREPARED	CHECKED	ENGR. APPL.	REV. DESCRIPTION	FILE
0	07-26-76	Manual Op				
7	06-11-80	W. GUADALUPE				
8	01-16-85	J.C. Gomez			FINAL ANALYSIS	X
4	10-17-87	W. GUADALUPE			UPDATED PIPE DATA FOR END STATION	
5	1-25-79	W. GUADALUPE			AS PER ANALYSIS	
6	03-26-79	W. GUADALUPE			PIPE REROUTED	
					MOVED 1 & ADDED 1 SUPPORT	

NO SCALE

FOR ANALYTICAL & PHYSICAL DATA
FOR REACTOR WATER CLEAN-UP SYSTEM

SARGENT & LUNDY

PROJECT CLINTON - I

CLIENT ILLINOIS POWER COMPANY

PROJECT NO. 5336 - 00

SUB SYSTEM NO. IRT 09

SHEET 1 OF 4

EMD-025062
ADDENDUM: H
PAGE: 49

Penetration IMC-026

REV.	NODE POINTS		LINE NUMBER	PIPE CLASS	PIPING DESIGN TABLE	MATERIAL		DESIGN PRES.	MAX. OPER.		O.D.	SCHD.	WALL THICK	INSUL. THICK	WEIGHTS - LBS./LINEAL FT.					
	FROM	TO				SPEC.	GR.		PRES.	TEMP.					1. PIPE	2. OPER. FLUID	3. INSUL.	OPER. TOTAL	4. WATER	HYDRO 1-4
		5	40	IRT 23C -4	B	607 CP	SA-106	B	1410	1141	120	4.500	120	0.438	0.0	18.98	4.47	0.00	23.45	4.47
	85	140	IRT 24A -4	C	"	"	"	1410	"	"	"	120	"	0.0	"	"	"	"	"	"
	45	194	IRT 23D -4	C	"	"	"	1410	"	"	"	120	"	0.0	"	"	"	"	"	"
	210	305	IRT 25B -4	D	106CP	"	"	150	25	"	"	40	0.297	0.0	18.79	5.51	"	16.30	"	"
	313	160	IRT 25A -3	D	"	"	"	150	25	"	3.500	40	0.216	0.0	7.98	3.20	"	10.78	"	"
	200	770	IRT 23E -4	D	106CP	"	"	150	25	"	4.900	40	0.237	0.0	18.79	5.51	"	16.30	"	"
	180	395	IRT 24B -4	D	"	"	"	150	25	"	"	40	0.237	0.0	"	"	"	"	"	"
	10	"	IRT 74A -3/4	B	607CP	"	"	1410	1141	"	1.050	160	0.219	0.0	1.94	0.128	"	2.068	0.128	2.068
	30	81	IRT 75A -3/4	C	607CP	"	"	1410	1141	"	1.050	160	0.219	0.0	1.94	0.128	"	2.068	"	2.068
	192	193	IRT 23E -1	C	607CP	"	"	1410	1141	"	1.315	160	0.250	0.0	2.84	0.226	"	3.066	0.226	3.066
	208	206	IRT 23F -1	D	106CP	"	"	150	25	"	1.315	80	0.173	0.0	2.17	0.312	"	2.482	"	2.482
	39	84	IRT 66A -3/4	C	607CP	"	"	1410	1141	"	1.050	160	0.219	2.0	1.94	0.128	4.9	2.968	0.128	2.068
	302	303	IRT 23A -3/4	D	106CP	"	"	150	25	120	1.050	80	0.154	0.0	1.47	0.188	0.00	1.658	"	1.658

REV.	NODE POINTS		TYPE	PRESSURE RATING	VAL. STROKING TIME (SEC.)		VAL./FIT. WT. LBS.		OPERATOR WT. LBS.		FLEXIBILITY INFO.		VENDOR	DRAWING NO.	REV.	REMARKS/OR VALVE NO.
	FROM	TO			PRELIM.	ACTUAL	PRELIM.	ACTUAL	O.D.	THICK						
		15	25	PLUG GATE	600#									ANCHOR/DARLING VALVE CO	WY782 0044	
	40	45	PLUG GATE	"			97				4.50		CRANE CATALOG			038 NO 11
	134	100	PLUG GATE	"							4.50		ANCHOR/DARLING VALVE CO	35-10006		1633F046
	140	150	PLUG GATE	"							4.50			35-10005		1633F035
	307	313	RELIEF	150							4.50		INDUSTRIAL VALVE & INSTR. DIV.	BNC 8007		1633F036
	305	307	FLANGE	150			15				4.50		CRANE			
	313	314	FLANGE	300			15				3.50		CRANE			

EMD-025062
ADDENDUM: H
PAGE: 53


RELEASE RECORD						FOR		SUB SYSTEM NO.	
REV.	DATE	PREPARED	CHECKED	ENG'R APPL.	REV. DESCRIPTION	PHM	CLIENT	PROJECT NO.	REV.
6	1-23-79	W. GUABALUPE			PIPE REROUTED		ILLINOIS POWER COMPANY	4536-00	8
6	03-26-79	W. GUABALUPE			MOVED & ADDED HANGERS	X			
7	06-11-80	<i>[Signature]</i>	<i>[Signature]</i>	<i>[Signature]</i>	FINAL ANALYSIS	X			
8	01-16-85	<i>[Signature]</i>	<i>[Signature]</i>	<i>[Signature]</i>	UPDATED PIPE DATA FOR EMD EVALUATION	X			

SARGENT & LORRY

SUB SYSTEM NO. IRT 09

PROJECT NO. 4536-00

SHEET 5 OF 6

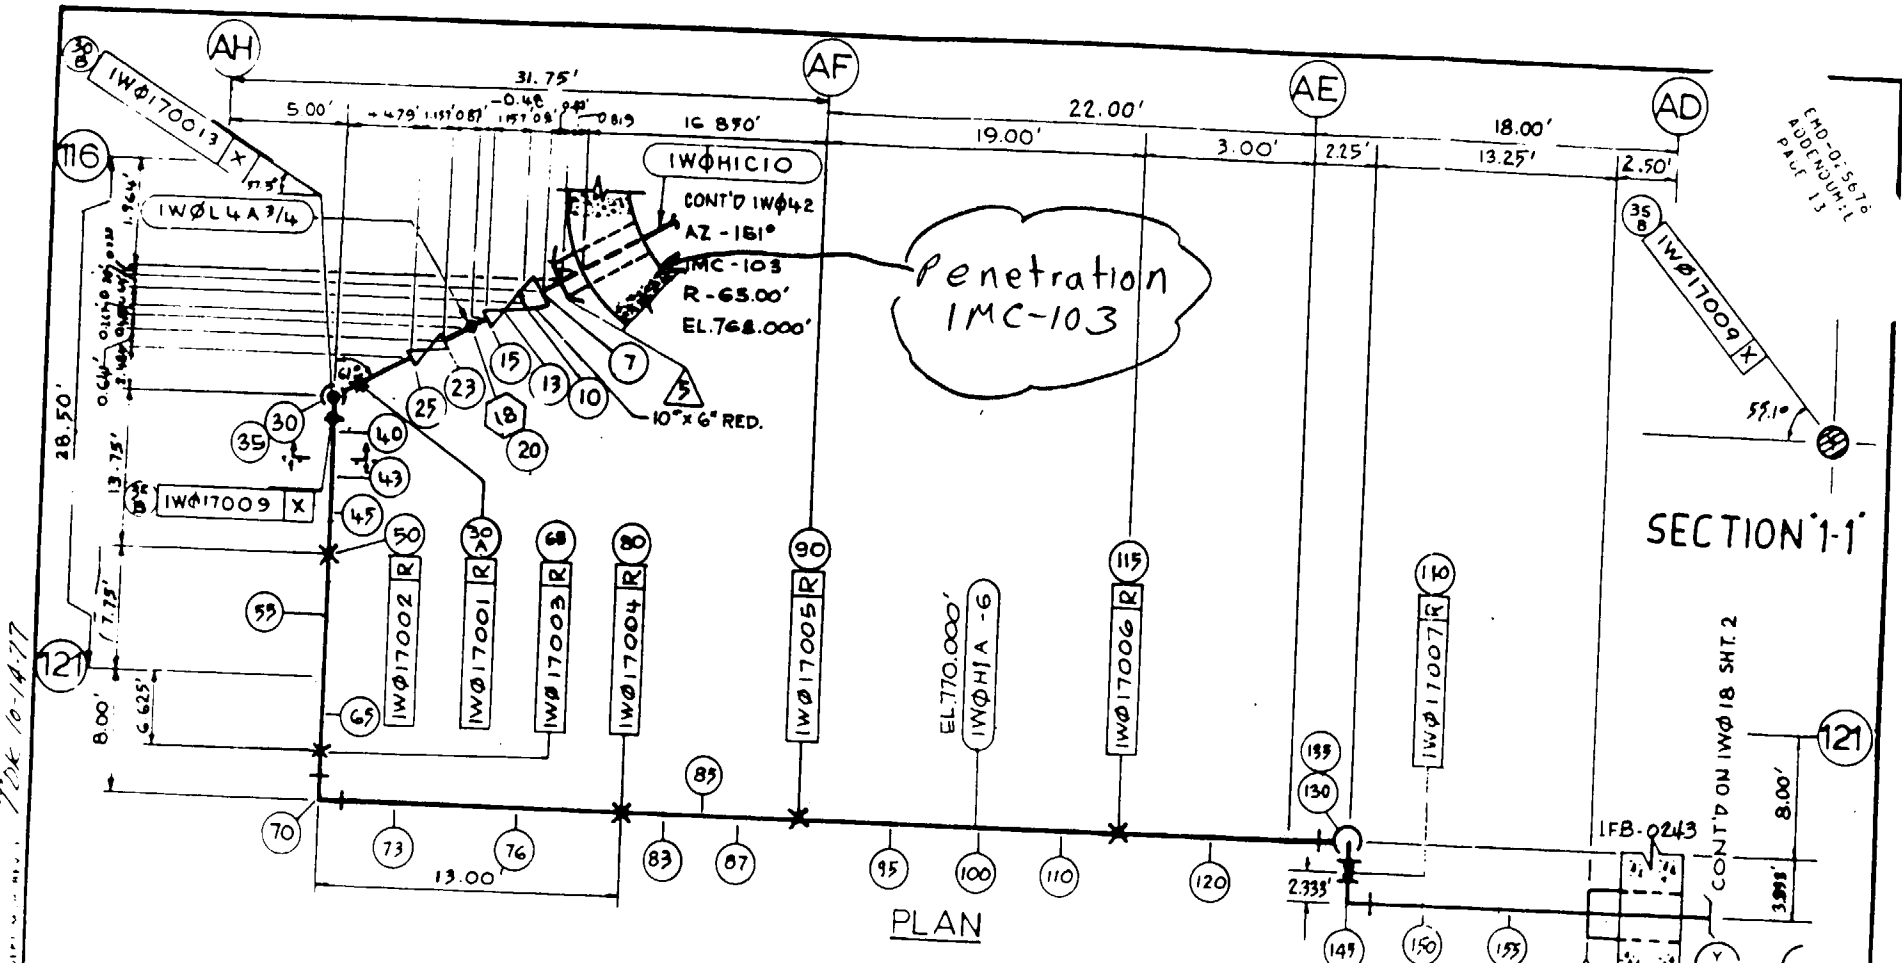

120x 10-14-77

C.M.D. 0-5516
ADDENDUM 1
P.L. 11

REFERENCE DRAWINGS	DWG NO	REV	DWG NO	REV	DWG NO	REV	DWG NO	REV	DWG NO	REV
	MOG-111719	J								
	428-1002-054									

RELEASE RECORD						
REV	DATE	PREPARED	REVIEWED	APPROVED	PURPOSE	FILM
0	03-22-78	<i>Lemoine</i>				
1	08-22-78	<i>A. J. Jones</i>				
2	08-30-78	<i>E. P. Passaro</i>			ADD'L RESTRAINTS ENTER ENGR'S COMMENTS	
3	07-27-80	<i>N.P. AQUILA</i>		<i>M. J. Palma</i>	FOR FINAL ANALYSIS	
4	11-26-84	<i>J. J. ...</i>		<i>J. ...</i>	UPDATED PIPE AND VALVE DATA FOR EMD EVALUATION	

07-19-82
FROZEN
REVISION TO THIS MYLAR
REQUIRES PROJECT MANAGER
APPROVAL

NO SCALE
PIPING ANALYTICAL & PHYSICAL DATA
FOR **PLANT CHILLED WATER** SYSTEM
PROJECT **CLINTON-1**
CLIENT **ILLINOIS POWER CO.**
PROJECT NO. 4536-00

SARGENT & LUNDY
CHICAGO
SUB SYSTEM NO. **1WØ17**
REV. **4**
SHEET 1 OF 3

Penetration IMC-105

REV	NODE POINTS		LINE NUMBER	PIPE CLASS	PIPING DESIGN TABLE	MATERIAL		DESIGN PRESS.	MAX. OPER.		O.D.	SCHED.	WALL THICK	INSUL. THICK	WEIGHTS - LBS./LINEAL FT.						
	FROM	TO				SPEC.	GR.		PRESS.	TEMP.					1. PIPE	2. OPER. FLUID	3. INSUL.	OPER. TOTAL	1+2+3	4. WATER	HYDRO 1+4
	5	15				1WØH1C10	B		106 CP	SA106					B	250	205	60	10.750	40	0.365
15	160	1WØH1A6	D	100	SA106	B	250	205	60	6.625	40	0.280	1.5	18.97	12.51	2.70	34.18				
18	20	1WØL4A3/4	D	100	SA106	B	250	205	100	1.050	80	0.164	1.5	1.47	0.188	0.91	2.57				

REV	NODE POINTS		TYPE	PRESSURE RATING	VAL. STROKING TIME (SEC.)		VAL./FIT. WT. LBS.		OPERATOR WT. LBS.		FLEXIBILITY INFO.		VENDOR	DRAWING NO.	REV.	REMARKS/VAL. NO.
	FROM	TO			OPEN	CLOSE	PRELIM.	ACTUAL	PRELIM.	ACTUAL	O.D.	THICK				
	10	15			MO GATE VA.	150										
23	25	GATE VA.	150				694 lbs.						ANCHOR/DARLING VALVE CO.	W7920688	A	1WØ001A
							148 lbs.						CRANE CO.	STD-K-6736-78		1WØ902

EMD-025678
ADDENDUM: E
PAGE 14

REV	DATE	PREPARED	CHECKED	ENG'R APPL	REV. DESCRIPTION	FILM
2	08-30-78	E POSADAS				
3	07-23-80	N. PAGUILA				
4	11-26-87	Juan Felipe Magallon		J. Magallon	FOR FINAL ANALYSIS UPDATED PIPE AND VALVE DATA FOR EMD EVALUATION	


PIPING ANALYTICAL & PHYSICAL DATA
FOR PLANT CHILLED WATER SYSTEM
PROJECT CLINTON-1
CLIENT ILLINOIS POWER CO.
PROJECT NO. 4536-00

SARGENT & LUNDY
CHICAGO


SUB SYSTEM NO. 1WØ17
REV. 4
SHEET 2 OF 3

SE 13-14, 15 10-FORM APPROVED 8-1-80 DEPT. MGR

EMD-048056
PAGE 13

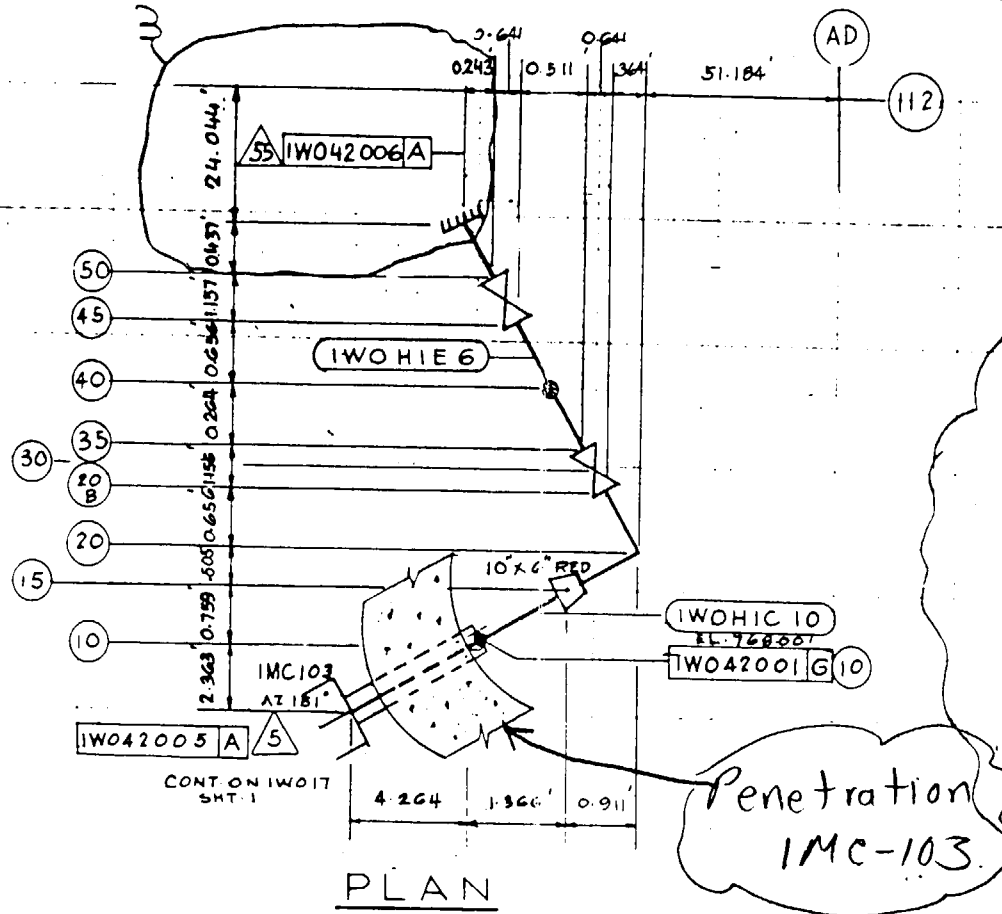

Penetration
IMC-103

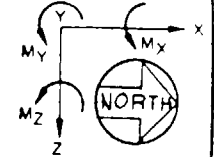

DEPT. MGR. REV. 1 5/20/10-14-77

REFERENCE DRAWINGS	DWG. NO.	REV.	DWG. NO.	REV.	DWG. NO.	REV.	DWG. NO.	REV.	DWG. NO.	REV.
	M06-1117-61	B	M05-1117-19	C						
	M06-1117-62	B								

RELEASE RECORD					
REV	DATE	PREPARED	REVIEWED	APPROVED	PURPOSE
0	04-05-79	M.U. ARCEO			
1	04-11-79	M.U. ARCEO	<i>[Signature]</i>	<i>[Signature]</i>	INC. ENGRS. COMMENTS
2	01-21-80	<i>[Signature]</i>	<i>[Signature]</i>	<i>[Signature]</i>	UPDATE ANALYTICAL DWG. FOR FINAL ANALYSIS
3	09-06-84	<i>[Signature]</i>	<i>[Signature]</i>	<i>[Signature]</i>	REVISED PER LATEST LINE LIST AND DIT-CP-SD-0157 FOR EMD EVALUATION


PIPING ANALYTICAL & PHYSICAL DATA	
FOR	PLANT CHILLED WATER SYSTEM
PROJECT	CLINTON-1
CLIENT	ILLINOIS POWER CO.
PROJECT NO	4536-00

NO SCALE	
SARGENT & LUNDY ENGINEERS CHICAGO	
SUB SYSTEM NO.	IWO42
REV.	3
SHEET 1 OF 3	

Penetration IMC-103

REV.	NODE POINTS		LINE NUMBER	PIPE CLASS	PIPING DESIGN TABLE	MATERIAL		DESIGN PRESS.	MAX. OPER.		O.D.	SCHED.	WALL THICK	INSUL. THICK	WEIGHTS - LBS/LINEAL FT.						
	FROM	TO				SPEC.	GR.		PRESS.	TEMP.					1. PIPE	2. OPER FLUID	3. INSUL	OPER TOTAL	1+2+3	4. WATER	HYDRO 1+4
	5	20B	IWOHIC10	B	106CP	A106	B	250	205	60	10.75	40	0.065	1.50	40.50	34.20	3.88	78.58	34.20	74.70	
	35	55	IWOHIE6	D	100	A106	B	250	205	60	6.625	40	0.280	1.50	18.97	12.51	2.63	34.11	—	—	

EMD-048056
PAGE 14

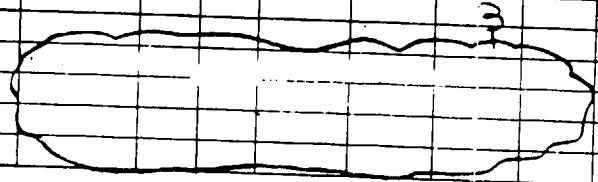

REV.	NODE POINTS		TYPE	PRESSURE RATING	VAL STROKING TIME (SEC.)		VAL./FIT. WT. LBS.		OPERATOR WT. LBS.		FLEXIBILITY INFO.		VENDOR	DRAWING NO.	REMARKS
	FROM	TO			OPEN	CLOSE	PRELIM.	ACTUAL	PRELIM.	ACTUAL	O.D.	THICK			
	20B	35	GATE VALVE	150											
	45	50	GATE VALVE	150				694	(INCL. OPERATOR)	6.625			ANCHOR DARLING VALVE CO	W7920689	1W00018 M.C.
								148		6.625			CRANE CO.	KG738	1W0303 M.

RELEASE RECORD						
REV.	DATE	PREPARED	CHECKED	ENG'R APP'L	REV. DESCRIPTION	FILM
0	04-05-79	MUARCEO				
1	04-11-79	MUARCEO			INC. ENGR'S COMMENTS	
2	01-21-80	MUARCEO			UPDATE ANALYTICAL DWG. FOR FINAL ANALYSIS	
3	09-06-84	Rayna Paul			REVISED PER LATEST TIME LIST AND DT-CF-82D-017 PER EMD EVALUATION	

PIPING ANALYTICAL & PHYSICAL DATA
FOR PLANT CHILLED WATER SYSTEM
PROJECT CLINTON-1
CLIENT ILLINOIS POWER CO.




PROJECT NO

SARGENT & LUNDY
ENGINEERS
CHICAGO

SUB SYSTEM NO.	REV.
IWO42	2


1-19-14 10 30 FORM APPROVED BY DEPT. MOR

EMD-025188
ADDENDUM: B
PAGE 11

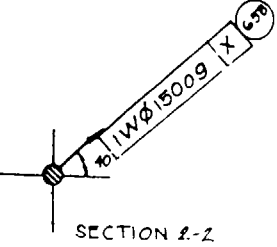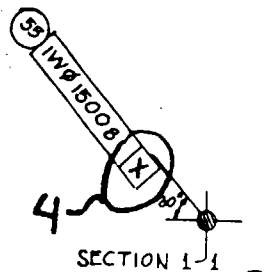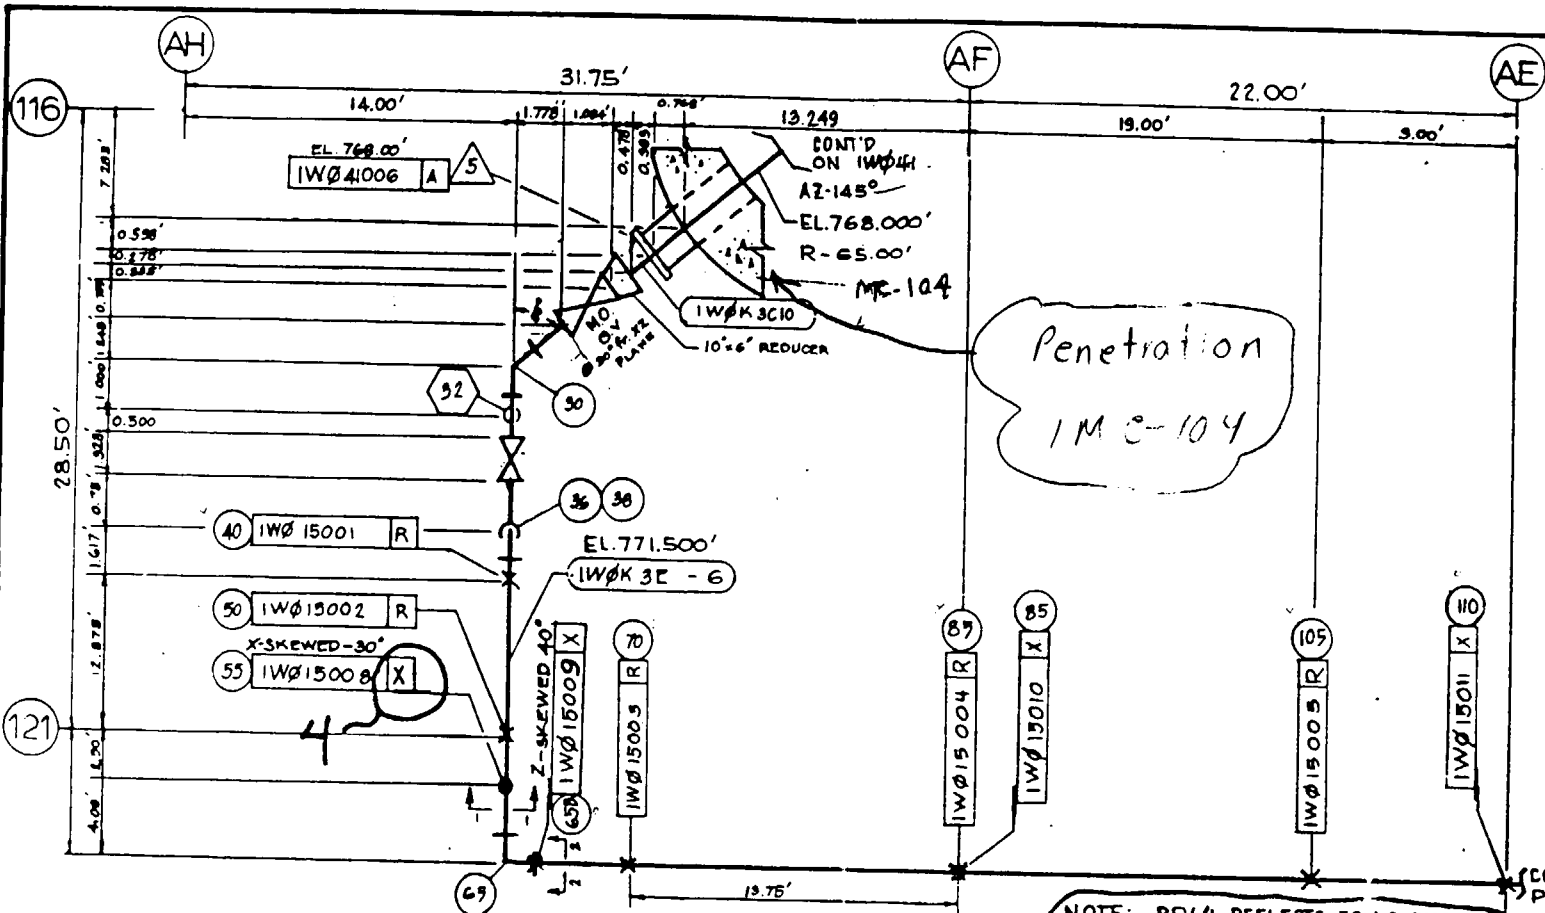

Penetration
IMC-104

NOTE: REV. 4 REFLECTS FOLLOWING CHANGES ONLY:
1. IWØ15008S CHANGED TO IWØ15008X AS PER ECN # 29591
2. WEIGHTS OF OPER. FLUID, INSUL. HYDRO, AND VALVE.
3. VALVE ADDED ON MODE DWG. (SHT. 4)

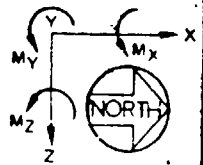

PLAN-A

DEPT. MOR. REV. 1 7/24/10-14-77

REFERENCE DRAWINGS	DWG. NO.	REV.	DWG. NO.	REV.	DWG. NO.	REV.	DWG. NO.	REV.	DWG. NO.	REV.
	M06-1117-10	G	M05-1117-16	D						
	M06-017-7	L	M05-1117-18	D						

RELEASE RECORD						
REV.	DATE	PREPARED	REVIEWED	APPROVED	PURPOSE	FILM
0	03-18-78	<i>lencic Paula</i>				
1	08-23-78	<i>A. Bonomo</i>			ADDL RESTRAINTS	
2	08-30-78	<i>A. Prosser</i>			ENTER ENGRS. COMMENTS	
3	08-26-82	<i>Tom G. ...</i>	<i>M. J. ...</i>		ENR ANALYSIS	
4	04-17-84	<i>I. Azbe</i>	<i>G. Chan</i>	<i>M. J. ...</i>	UPDATED PIPE & VALVE DATA	

PIPING ANALYTICAL & PHYSICAL DATA
FOR **PLANT CHILLED WATER** SYSTEM
PROJECT **CLINTON-1**
CLIENT **ILLINOIS POWER CO.**
PROJECT NO. **4536-00**

NO SCALE

SARGENT & LUNDY
CHICAGO

SUB SYSTEM NO. | REV
1W015 | **4**

SHEET 1 OF 4

Penetration IMC-104

PIPE DATA																				
R E V.	NODE POINTS		LINE NUMBER	PIPE CLASS	PIPING DESIGN TABLE	MATERIAL		DESIGN PRESS.	MAX. OPER.		O.D.	SCHED.	WALL THICK	INSUL. THICK	WEIGHTS - LBS./LINEAL FT.					
	FROM	TO				SPEC.	GR.		PRESS.	TEMP.					1. PIPE	2. OPER. FLUID	3. INSUL.	4. TOTAL (1+2+3)	A. WATER	HYDRO H4
	8	10	IWOK3C-10	B	106 CP	SA106	B	250	205	60	10.75	40	0.865	1.5	40.80	34.2	3.95	78.65	34.2	74.70
	25	140	IWOK3E-6	D	100	SA106	B	250	205	60	6.625	40	0.280	1.5	19.00	12.50	2.63	34.13	0	
	--																			

EMD-025188
ADDENDUM: B
PAGE 13

45

VALVE & SPECIAL FITTINGS DATA																
R E V.	NODE POINTS		TYPE	PRESSURE RATING	VAL. STROKING TIME (SEC.)		VAL./FIT. WT. LBS.		OPERATOR WT. LBS.		FLEXIBILITY INFO.		VENDOR	DRAWING NO.	R E V.	REMARKS / VAL. NO.
	FROM	TO			OPEN	CLOSE	PRELIM.	ACTUAL	PRELIM.	ACTUAL	O.D.	THICK				
	15	25	M.D. GATE V	150									ANCHOR DARTING VALVE Co	W-792688	A	IW0002A
	33	36A	GATE VALVE	150			4	694.0					CRANE	K-6738-K	K	IW0307

RELEASE RECORD					
REV.	DATE	PREPARED	CHECKED	ENG'R APPL	REV. DESCRIPTION
3	08-02-80	<i>[Signature]</i>	<i>[Signature]</i>	<i>[Signature]</i>	FINAL ANALYSIS
4	04-17-84	<i>[Signature]</i>	<i>[Signature]</i>	<i>[Signature]</i>	UPDATED PIPE & VALVE DATA


FOR PIPING ANALYTICAL & PHYSICAL DATA
PLANT CHILLED WATER SYSTEM
 PROJECT CLINTON-1
 CLIENT ILLINOIS POWER CO.
 PROJECT NO 4596-00

SARGENT & LUNBY
 CHICAGO
 SUB SYSTEM NO. 1W015
 REV. 4
 SHEET 3 OF 4

ME-15 153 (8-78) FORM APPROVED 8-78 DEPT. M&E

70K 10-14-77

DEPT. MGR. REV. 1
BY 18-10-118731 FROM APPROVED BY

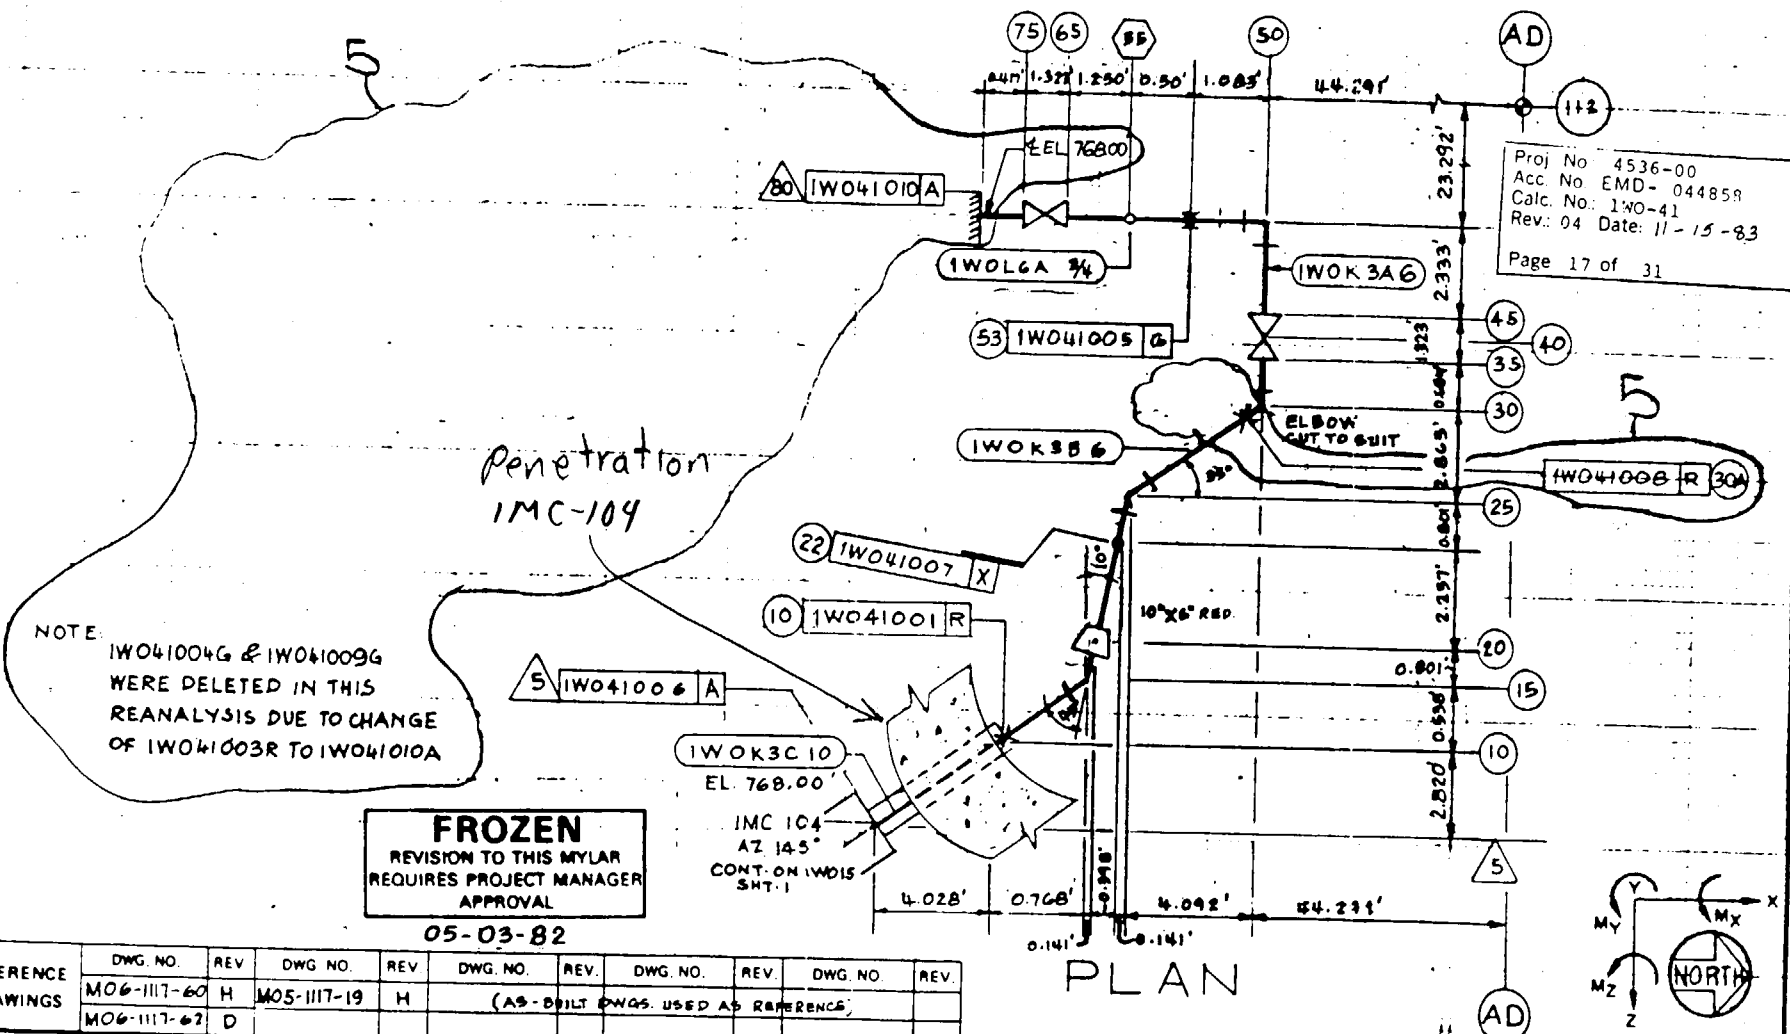

NOTE: IW041004G & IW041009G WERE DELETED IN THIS REANALYSIS DUE TO CHANGE OF IW041003R TO IW041010A

FROZEN
REVISION TO THIS MYLAR
REQUIRES PROJECT MANAGER
APPROVAL

05-03-82

IW0K3C10
EL. 768.00
IMC 104
AZ 145°
CONT. ON IW0410
SHT. 1

PLAN

Proj No 4536-00
Acc. No EMD- 044859
Calc. No: 1W0-41
Rev: 04 Date: 11-15-83
Page 17 of 31

REFERENCE DRAWINGS	DWG. NO.	REV	DWG. NO.	REV	DWG. NO.	REV.	DWG. NO.	REV.	DWG. NO.	REV.
	MO6-1117-60	H	MO5-1117-19	H						
	MO6-1117-62	D								

(AS-BUILT DWGS. USED AS REFERENCE)

RELEASE RECORD						
REV	DATE	PREPARED	REVIEWED	APPROVED	PURPOSE	FILM
0	04-04-79	M. U. ARCEO				
1	04-11-79	M. U. ARCEO		M. J. A. Panna	INC. ENGR'S COMMENTS	
2	01-15-80	M. U. ARCEO		M. J. A. Panna	UPDATE ANALYTICAL DWG. FOR FINAL ANALYSIS	
3	03-12-82	A. Warril		M. J. A. Panna	FOR "RECORD" ANALYSIS	
4	07-19-83	A. Warril		M. J. A. Panna	FOR RE-ANALYSIS DUE TO NCR 007	
5	09-01-83	R. Warril		M. J. A. Panna	UPDATED PER STRESS REPORT # 044859 REV. 4	

PIPING ANALYTICAL & PHYSICAL DATA
FOR PLANT CHILLED WATER SYSTEM
PROJECT CLINTON-1
CLIENT ILLINOIS POWER CO.
PROJECT NO. 4536-00

NO SCALE

SARGENT & LUNDY
CHICAGO

SUB SYSTEM NO.	REV.
IW041	5

SHEET 1 OF 3

Penetration IMC-104

PIPE DATA

REV.	NODE POINTS		LINE NUMBER	PIPE CLASS	PIPING DESIGN TABLE	MATERIAL		DESIGN PRESS.	MAX. OPER.		O.D.	SCHED.	WALL THICK	INSUL. THICK	WEIGHTS - LBS./LINEAL FT.						
	FROM	TO				SPEC.	GR.		PRESS.	TEMP.					1. PIPE	2. OPER. FLUID	3. INSUL.	OPER. TOTAL	1+2+3	4. WATER	HYDRO 1+4
		5				20	IWOK3C10		B	106CP					A106	B	250	205	60	10.750	40
	20	35	IWOK3B6	B	106CP	A106	B	250	205	60	6.625	40	0.280	1.50	18.97	12.51	2.464	33.94	12.51	31.46	
	45	60	IWOK3A6	D	100	A106	B	250	205	60	6.625	40	0.280	1.50	18.97	12.51	2.464	33.94	12.51	31.46	
	55	60	IWOL6A3/4	D	100	A106	B	250	205	100	1.050	80	0.154	1.50	1.94	0.128	0.848	2.92			

† CODED AS SOCKET

VALVE & SPECIAL FITTINGS DATA

REV.	NODE POINTS		TYPE	PRESSURE RATING	VAL. STROKING TIME (SEC.)		VAL./FIT. WT. LBS.		OPERATOR WT. LBS.		FLEXIBILITY INFO.		VENDOR	DRAWING NO.	REV.	REMARKS
	FROM	TO			OPEN	CLOSE	PRELIM.	ACTUAL	PRELIM.	ACTUAL	O.D.	THICK				
		35			45	GATE VALVE	150									
	65	75	GATE VALVE	150									ANCHOR DARLING VALVE	W7920688		IW0002B M.O.
													CRANE CO.	K-6738		IW0806 M.

Proj. No.: 4536-00
 Acc. No.: EMD- 044858
 Calc. No.: 1W0-41
 Rev.: 04 Date: 11-15-83
 Page 18 of 31

RELEASE RECORD

REV.	DATE	PREPARED	CHECKED	ENG'R APPL.	REV. DESCRIPTION	FILM
0	04-04-79	M. U. ARCEO				
1	04-11-79	M. U. ARCEO				
2	01-15-80	M. Arceo		M. J. McNamee	INC. ENG'RS COMMENTS	
3	03-18-82	A. Carol		M. J. McNamee	UPDATE ANALYTICAL DWG FOR FINAL ANALYSIS	
4	07-14-83	A. Dorris		M. J. McNamee	FOR 'RECORD' ANALYSIS	
5	09-01-83	Regina Pearl		M. J. McNamee	FOR RE-ANALYSIS DUE TO NCR 8897	

PIPING ANALYTICAL & PHYSICAL DATA
 FOR PLANT CHILLED WATER SYSTEM
 PROJECT CLINTON-1
 CLIENT ILLINOIS POWER CO.
 PROJECT NO. 4536-00

SARGENT & LUNDY
 CHICAGO
 SUB SYSTEM NO. 1W041
 REV. 5
 SHEET 2 OF 5

ME - 18 10 7 18 781 FORM APPROVED 8-83 DEPT. MGR.

Responses to Questions Received by Facsimile on August 21, 2000

The following are the specific responses to the questions faxed to CPS on August 21, 2000.

Question 1: Condensation induced waterhammer (CIWH) was not analyzed. Are there any long horizontal piping runs in the Drywell (VP) or Supplemental Drywell (WO) cooling systems where CIWH could occur? CIWH might occur either during the draining of the VP and WO systems or the subsequent refill.

Response: There are no locations in the Drywell (VP) or Supplemental Drywell (WO) cooling systems where CIWH could occur because no vapor bubble of significant size can form. The systems are not subject to drain down and refill post-LOCA. The system configuration which prevents water hammer is described in more detail in Attachment 3 to this letter.

Question 2: Describe the isolation valves for the VP and WO systems. What is their position during plant operation? Do they receive an automatic containment isolation closure signal?

Response: The cooling systems in the drywell are non-safety related systems not credited for post-accident cooling. The VP and WO systems are power generation systems, which provide cooling water for economic purposes during plant operation. As such, the containment isolation valves receive a containment isolation signal (based on High Drywell Pressure or Reactor Vessel Low Water Level) as required by NUREG-0737, Item II.E.4.2, "Containment Isolation Dependability." As described in the CPS letter dated June 15, 1998, the emergency operating procedures allow operators to override the containment isolation signal and re-establish containment cooling. The VP and WO systems are described in more detail in Attachment 3.

Question 3: Could you provide a system diagram of the VP and WO systems showing the location of the containment isolation valves?

Response: P&ID's for these systems are attached.

Question 4: Relief valve 1VP024 is described as opening at a set pressure of 140 psid. What is the pressure at which the valve would close if it were opened by water expansion in the system piping? Compare the closure pressure to the conditions within the containment for a LOCA.

Response: Relief valves 1VP024 A/B are thermal relief valves, which are expected to seep, but not pop under slow thermal expansion conditions. If the valve does open it is expected to reset (close) within 10% of the set pressure or about 125 psig. Maximum post-accident temperature and pressure in containment are 185°F and 15 psig. The inboard isolation valves are within the drywell, where the maximum post-accident temperature is 330°F. The saturation pressure at 330°F is

approximately 89 psig. The range of possible system pressures and temperatures is described in more detail in Attachment 3.

ZM-GOM

OW003PA, OW003PB & OW003PC
PLANT CHILLED WATER SYSTEM
PUMPS A, B & C
K-2825


REV. 3 SEPT. 1991

OW004T
PLANT CHILLED WATER SYSTEM
COMPRESSION TANK
K-2839

OW002CA, OW002CB & OW002CC
PLANT CHILLED WATER SYSTEM
CHILLERS A, B & C
K-2805A

IW006M
CHEMICAL FEEDERS
BY I.P.C.


IW007M
CORROSION TEST RACK
(FIELD FAB.)

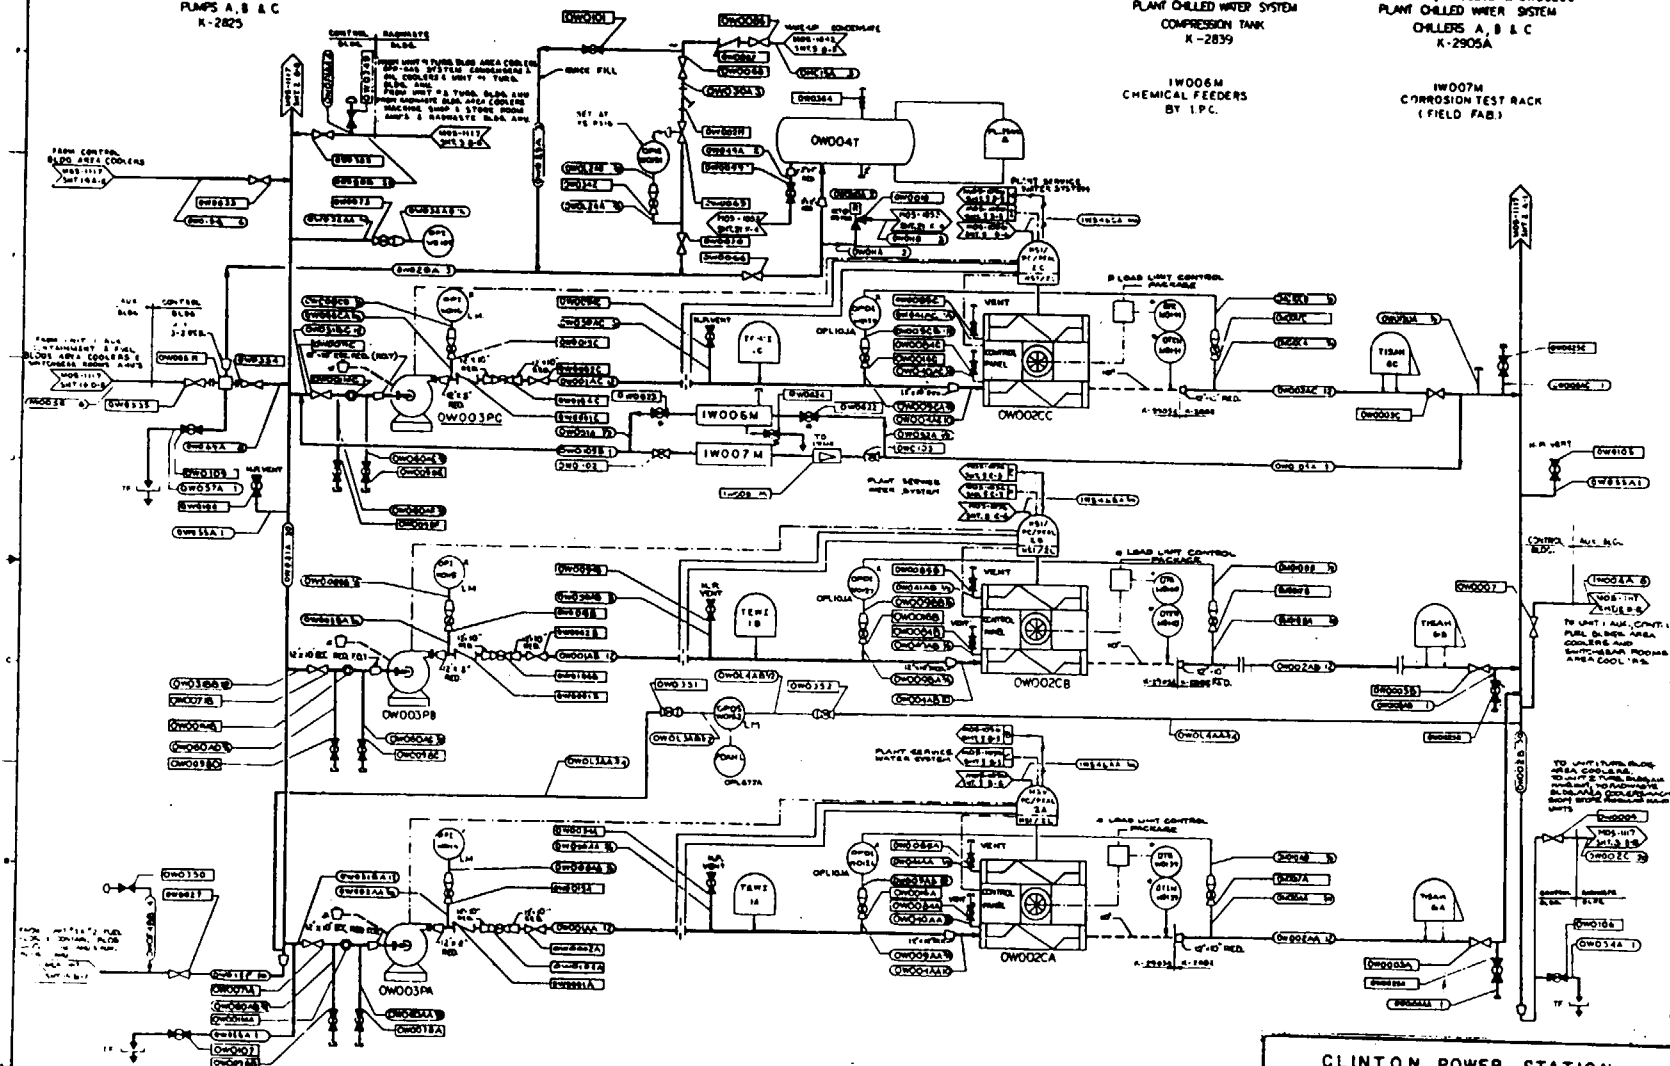

CLINTON POWER STATION
UPDATED SAFETY ANALYSIS REPORT

FIGURE 9.2-15

STATION CHILLED WATER SYSTEM
SHEET 1 OF 26

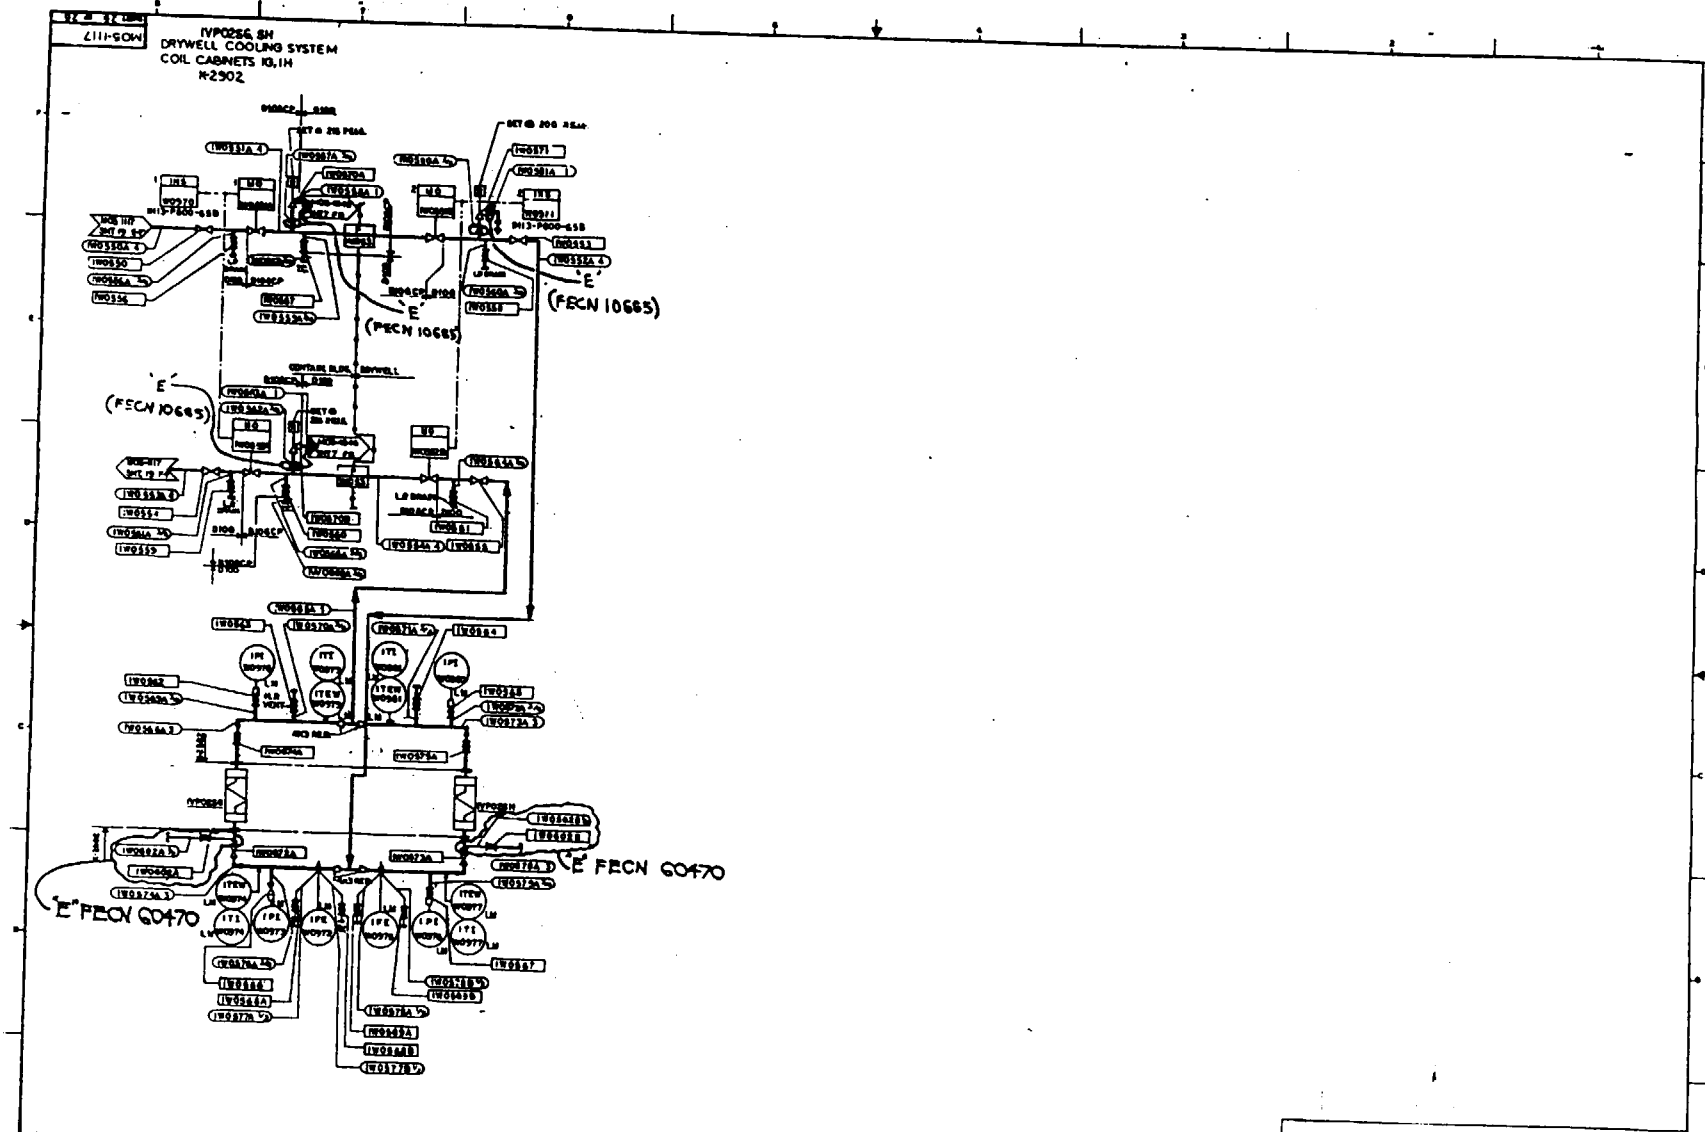

General Discussion of LOCA-Generated Waterhammer in CPS Drywell Cooling Systems

Description of Systems

The Drywell Cooling (VP) System and Supplemental Drywell Cooling systems (WO) are non-safety-related, closed-loop systems that support normal operation of the plant. The systems' containment isolation valves are open during normal operation and receive a close signal in the event of a LOCA (High Drywell Pressure or Reactor Vessel Low Water Level).

Each system contains a pressurized head tank located outside containment that provides system make-up and maintains the required pressure on the suction of the respective system pumps, which are also located outside containment. The make-up for each system is also non-safety related.

The VP system contains a compression tank located in the auxiliary building at approximately elevation 757' that is normally pressurized to 35 psig. The VP system pumps operate with a normal discharge pressure of approximately 100 psig. On a loss of offsite power the pumps are tripped, but the system water volume is maintained since the system is closed and pressurized. On a containment isolation signal, the volume of water in the closed system inside containment (drywell) is also trapped within the containment/drywell, maintaining this loop water solid. Since the loop is water solid, any heat-up from elevated drywell ambient temperatures will cause expansion of the fluid, which will lift relief valve 1VP024A or B. These thermal relief valves are set at 140 psig and are located inside the drywell. Additional relief valves (1VP027A/B and 1VP023A/B) are located inside containment and protect the length of piping between the containment isolation valves.

The WO system provides chilled water for power generation systems throughout the plant, including containment cooling and drywell supplemental cooling. It contains a compression tank located outside containment at elevation 762' that is normally pressurized to 75 psig. The remaining aspects of this system are similar to the VP System, except that relief valve 1WO327 is set at 250 psig.

System Response to a DBA LOCA

Due to the slow heat-up caused by ambient heat transfer through the piping insulation, the relief valves 1VP024A/B are not expected to lift (pop), but to "weep" maintaining system pressure very near to 140 psig. However, if the relief valves do lift, the minimum expected reset pressure is 140 psig – 10% (i.e., 125 psig). The maximum design drywell temperature during a DBA LOCA is 330°F, which is well below the saturation temperature at 125 psig. The maximum containment temperature of 185°F is also below the saturation temperature at atmospheric pressure.

The maximum temperature of 330°F occurs during a postulated Main Steam Line Break (MSLB) and is short lived. The temperature decays to less than 250°F in less than 10 seconds and to approximately 240°F in 100 seconds. The drywell temperature following a Recirculation Line break has a lower peak and also falls to approximately 240°F within 100 seconds. [See USAR figures 6.2-3 and 6.2-12 (copies provided as pages 4 and 5 of this attachment).] In less than two

minutes, sufficient heat transfer cannot occur between the atmosphere and the insulated piping for the fluid to exceed 240°F.

The emergency operating procedures (EOP-6) allow operators to restore drywell cooling if drywell temperature exceeds preset limits (150°F). Restoration requires defeating the containment isolation interlocks by installing jumpers per EOP support procedure 4410.00C006. This procedure contains cautions to prevent water hammer if drywell temperature is above 212°F when restoring chilled water flow. These cautions require maintaining a compression tank pressure of at least 30 psig if temperature is up to 270°F prior to opening the containment isolation valves. (Saturation pressure at 270°F is approximately 27 psig.) Normal tank pressure is higher than 30 psig for both systems. The EOP's do allow the emergency response organization to provide other guidance, if needed.

In a DBA LOCA, the predicted drywell temperature after 100 seconds is about 240°F, which corresponds to a saturation temperature of approximately 10 psig. Accounting for elevation differences, the static pressure in either the VP or WO system will be above saturation pressure for a temperature of 240°F at all points in the system, with about 5 psi of margin.

Water Hammer Discussion

Since the pressure in the VP and WO systems is not expected to drop below saturation pressure following a LOCA, a significant vapor bubble cannot form. These systems have already been evaluated for conventional water hammer (bubble collapse) impact on the containment isolation valves for conservatism.

Even if post-LOCA temperatures caused the formation of a vapor bubble in the system(s), the bubble that would be formed would cause only the conventional water hammer already evaluated. The vapor would collect at high points in the system, forming a limited size bubble that would collapse at a wave speed corresponding to the pumping rate or less. This type of bubble has been evaluated for impact to the containment isolation valves as described in the CPS supplemental response to GL 96-06 dated June 15, 1998. No other parts of the systems inside the drywell are safety related. These systems are evaluated for seismic interactions (II over I concerns), but breach of system integrity following a LOCA is not a concern for equipment qualification or flooding. (By design, the Mark III containment forms a large pool inside the drywell following a LOCA. Increased water inventory would increase heat sink size and decrease the severity of the accident).

NUREG/CR 5220 attributes condensation-induced water hammer to five different phenomena and places them in five corresponding classes. The watercannon and thermal inversion classes require physical configurations unlike those present in a drywell cooling system.

The subcooled water slug that can occur in long horizontal lines requires a large void, a high pressure steam source, and fill water that is subcooled. In the configurations applicable to the drywell cooling systems, a large void cannot form and no steam source is available. If a void is formed, the wave front of water that will approach any void will be at approximately saturation temperature, so a sudden collapse due to condensation will not occur, although conventional water hammer may occur.

Saturated water slugs occur in lines that are steam/vapor filled with a condensation slug forming at a low point in the system. In a drywell cooling system, this would require a complete system draindown. The CPS configuration is such that only a breach of the piping would allow such a draindown.

Although the system configuration does not have closed valves in vertical piping that could provide a location for component-trapped voids, high points at coolers could constitute a similar configuration. However, in this case the impact surface is not flat and the differential pressure is driven by the pumping rate. As described in NUREG/CR 5220, volume I, the slug velocities are limited by the pumping rate. For small relatively low flow rate in lines such as the drywell cooling system (at high points, the lines are no larger than 8" and flow rates are no greater than 830 gpm), the impact velocity is similar to the conventional water hammer velocities already evaluated.

Summary:

The configuration and operation of the VP and WO systems is such that no vapor bubble is expected to form under design basis accident conditions. For conservatism, CPS evaluated a conventional water hammer event for its impact on the containment isolation valves. If a vapor bubble does form, its size will be limited and the basic system configuration will prevent a water hammer of greater magnitude than the conventional water hammer already evaluated.

Additional Pages:

Drywell Temperature profiles – 2 pages

Drywell Cooling P&ID (Div 1 only) – 1 page (Attachment 2, page 3 of 5)

Supplemental Cooling P&ID (portions) – 2 pages (Attachment 2, pages 4 and 5)

References:

1. P&ID's M05-1109, sheets 2 and 3
2. P&ID's M05-1117, sheets 1, 19, 20, and 26
3. Wiring Diagrams E02-0WO99, sheets 9 and 10
4. Wiring Diagrams E02-1VP99, sheets 7, 8, 9, 10, 11, 12, and 13
5. Emergency Operating Procedure 6, Primary Containment Control
6. EOP Support Procedure 4410.00C006, Defeating VP/WO Interlocks
7. M06-1109, sheets 3, 4, 5, 6, and 9
8. M07-1109, sheet 2
9. M06-1117, Sheets 53, 60, 61, 62, and 63

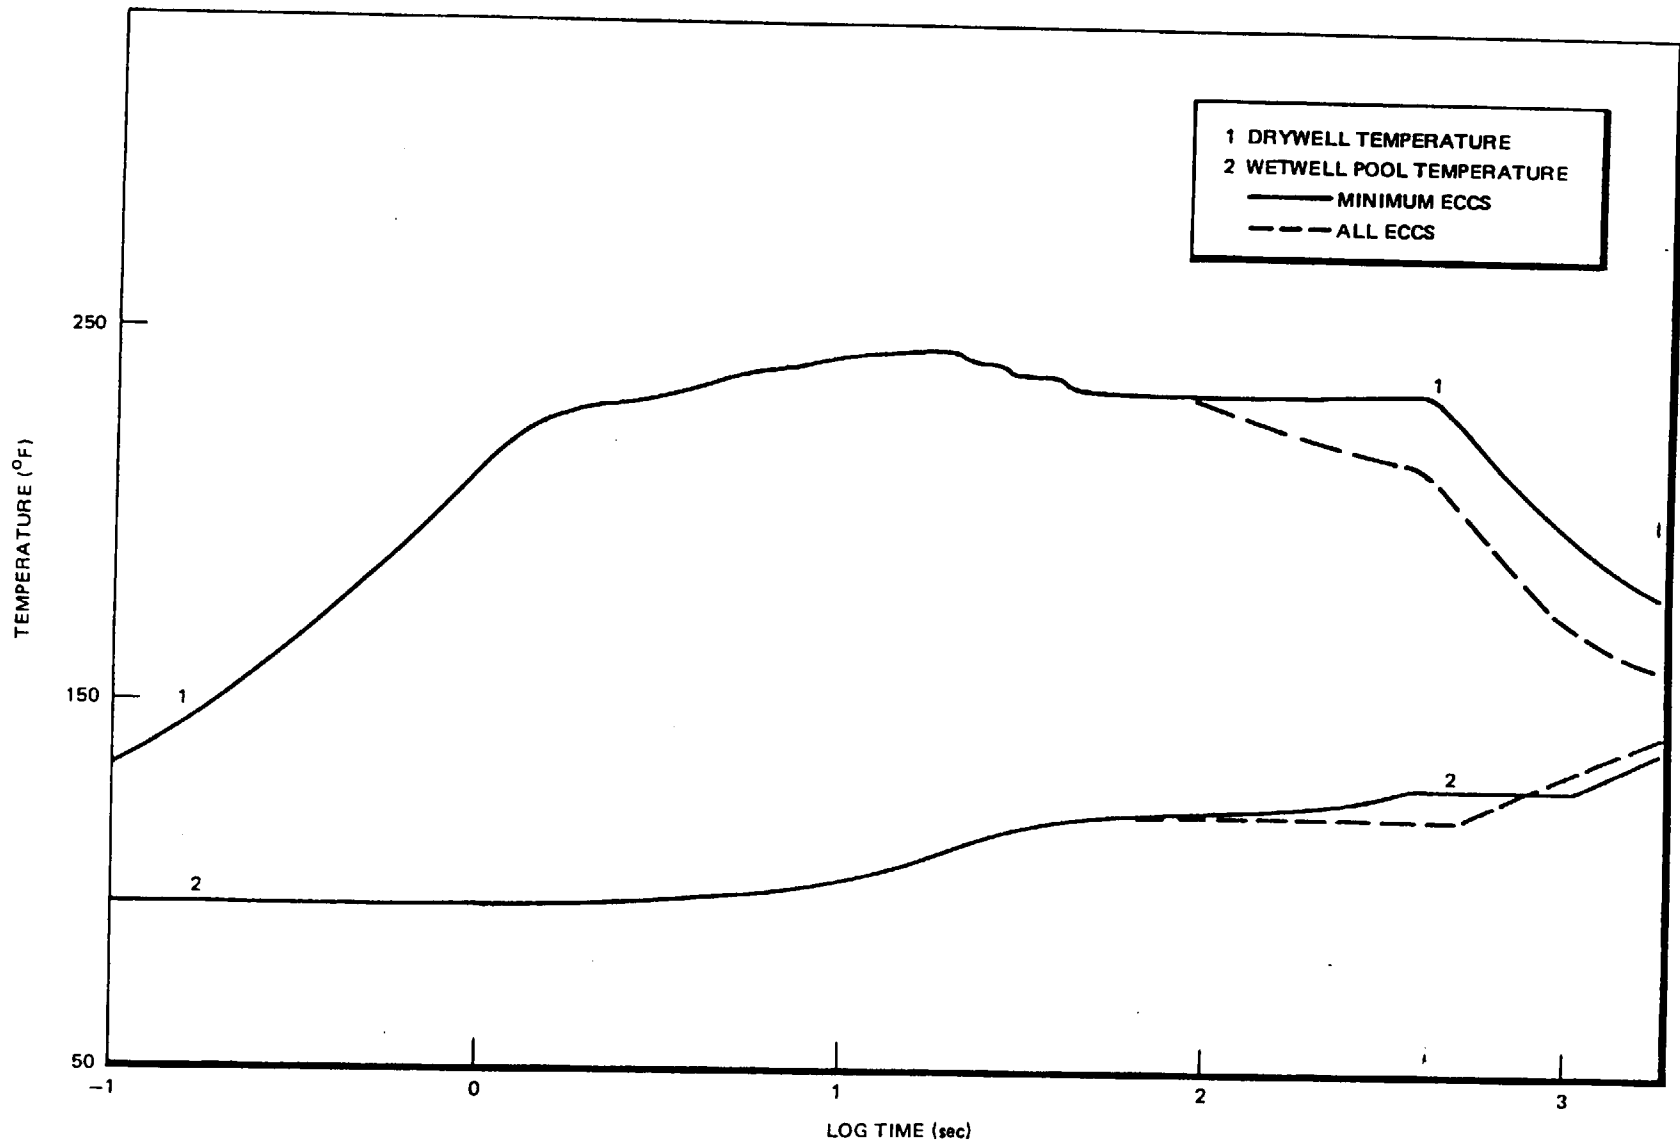


Figure 6.2-3. Short-Term Temperature Response Following a Recirculation Line Break

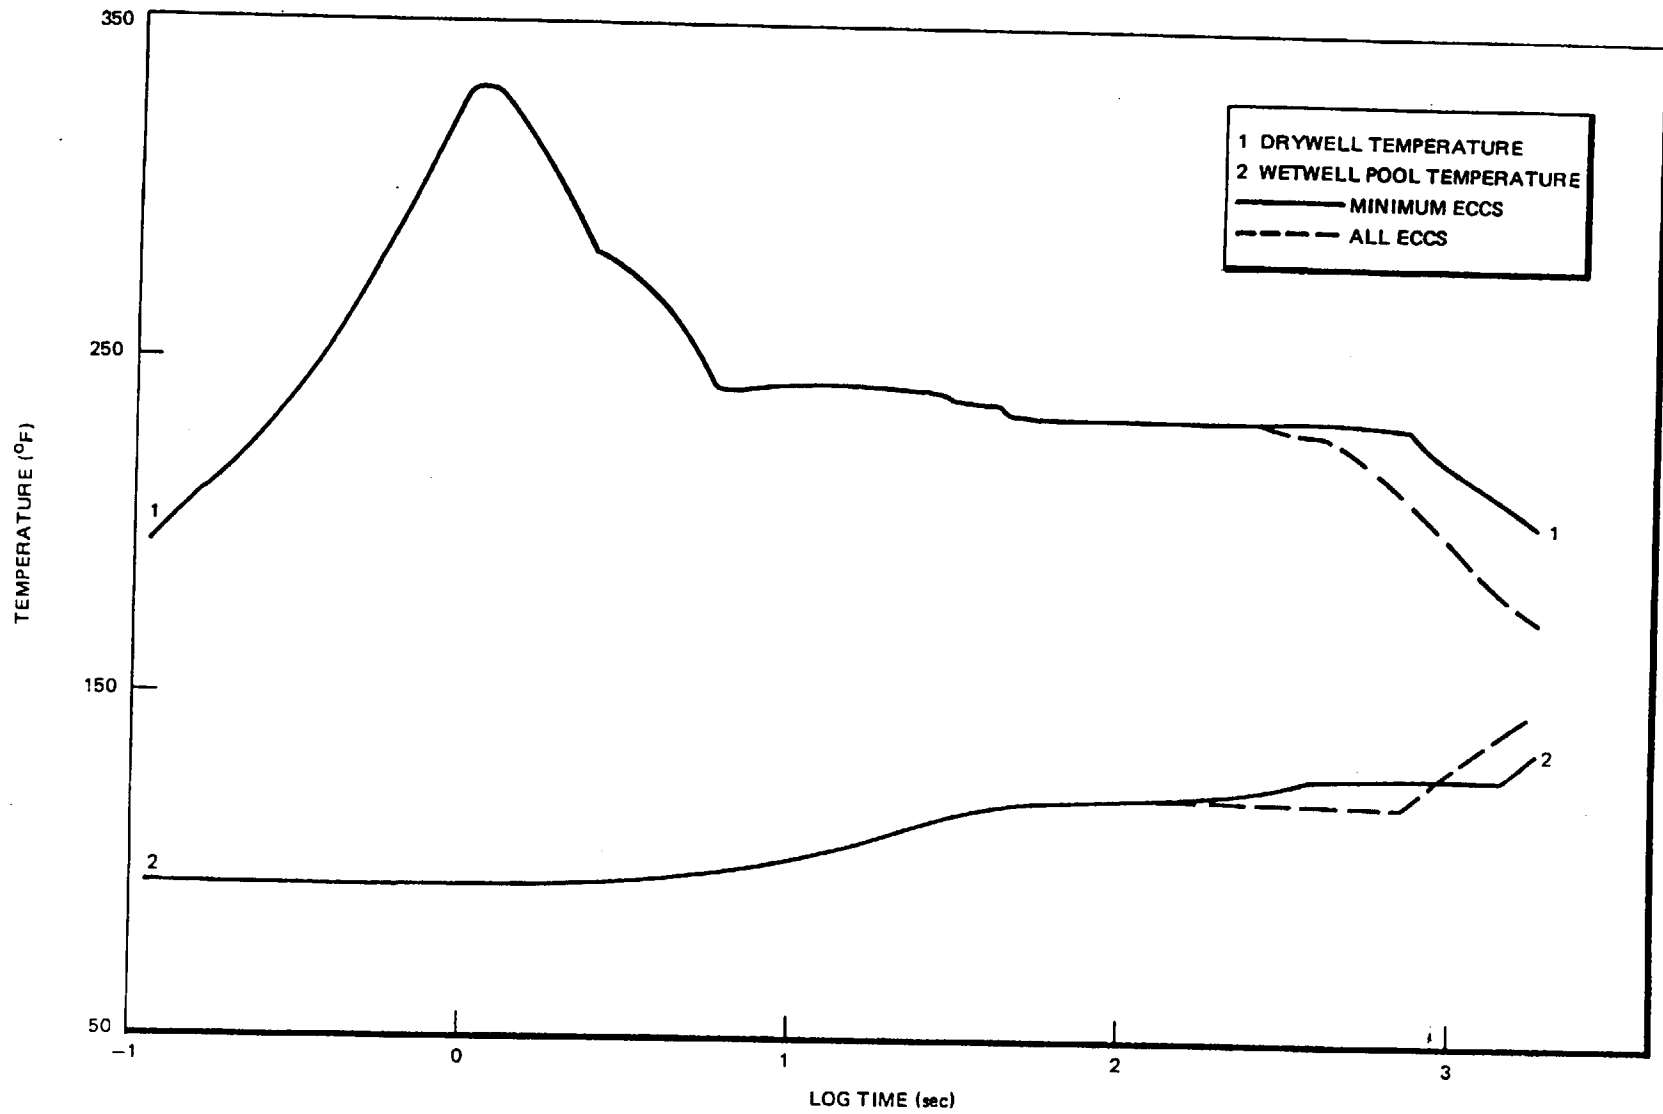


Figure 6.2-12. Short-Term Temperature Response Following a Main Steamline Break

The following Table provides a summary of the disposition of all the CPS containment penetrations related to the penetration pressurization issue discussed in Generic Letter 96-06. This table is an updated version of Attachment 3 to CPS letter dated January 28, 1997. The 23 justification categories provided in the earlier letter have been summarized into 7 categories. Penetrations listed as crediting valve leakage in the earlier letter are now noted with the final disposition. Penetrations with multiple lines are annotated if the justification is different for the different lines. Some typographical errors were also corrected.

NO.	SYSTEM	DESCRIPTION	JUSTIFICATION
1MC-001		Equipment Hatch	2
1MC-002		Personnel Lock	2
1MC-003		Personnel Lock	2
1MC-004		Fuel Transfer Tube	2
1MC-005	MS	Main Steam "C"	2
1MC-006	MS	Main Steam "A"	2
1MC-007	MS	Main Steam "D"	2
1MC-008	MS	Main Steam "B"	2
1MC-009	FW	Feedwater "A"	1
1MC-010	FW	Feedwater "B"	1
1MC-011	RH	RHR Pump Suction "A"	1
1MC-012	RH	RHR Pump Suction "B"	1
1MC-013	RH	RHR Pump Suction "C"	1
1MC-014	RH	RHR Shutdown Suction	6
1MC-015	RH	RHR LPCI "A"	3
1MC-016	RH	RHR LPCI "B"	3
1MC-017	RH	RHR LPCI "C"	1
1MC-018	RH	RHR Test to Supp. "A"	1
1MC-019	RH	RHR Test to Supp. "C"	1
1MC-020	RH	RHR Test to Supp. "B"	1
1MC-021	RH	RHR "A" P.R.V	1
1MC-022		Spare	2
1MC-023	RH	RHR "A" P.R.V.	1
1MC-024	RH	RHR "A" P.R.V.	1
1MC-025	RH	RHR "B" P.R.V. (Pump Suction)	1
1MC-026	RH	RHR "B" P.R.V. (Heat Exchanger)	1
1MC-027	RH	RHR "B" P.R.V. (Shutdown Return)	1
1MC-028	RI	RCIC Pump Suction	1
1MC-029	RH	RHR "C" P.R.V. (Pump Suction)	1
1MC-030	RH	RHR "C" P.R.V. (Pump Discharge)	1
1MC-031	RH	RHR "B" P.R.V. (Crosstie to RCIC)	1
1MC-032	LP	LPCS Pump Suction	1
1MC-033	HP	HPCS Test to Supp.	1
1MC-034	SF	Suppression Pool Clean Up	1
1MC-035	HP	HPCS Pump Discharge	1
1MC-036	LP	LPCS Pump Discharge	1
1MC-037	HP	HPCS Pump Suction	1
1MC-038	LP	LPCS P.R.V. (Pump Discharge)	1
1MC-039		Spare	2

NO.	SYSTEM	DESCRIPTION	JUSTIFICATION
1MC-040	RI	RCIC Min. Flow	1
1MC-041	RI	RCIC Turbine Steam Exhst.	2
1MC-042	RI	RCIC Head Spray	1
1MC-043	RI	RCIC Turbine Steam Supply	2
1MC-044	RI	RCIC Turbine Vacuum breaker	2
1MC-045	MS	Main Steam Drain	4
1MC-046	CC	CC Supply	6
1MC-047	CC	CC Return	6
1MC-048	SX	SX Service Water Supply	5
1MC-049	RA	Breathing Air	2
1MC-050	MC	Make-up Condensate (MC)	3
1MC-051		Spare	2
1MC-052	FC	Fuel Pool Cooling & Cleanup	3
1MC-053	FC	Fuel Pool Cooling & Cleanup	3
1MC-054		Spare	2
1MC-055		Spare	2
1MC-056	FP	F.P. Containment Standpipe	3
1MC-057	IA	Instrument Air	2
1MC-058	IA	Instrument Booster Air	2
1MC-059	SA	Service Air	2
1MC-060	RT	RWCU Pump Supply	4
1MC-061	RT	RWCU Pump Return	4
1MC-062	HG	Hydrogen Recombiner to Cont.	2
1MC-063	RD	C.R.D. Pump Discharge	1
1MC-064	RT	RWCU to RHR Return	4
1MC-065	WX	Radwaste Repro. & Disposal	3
1MC-066		Spare	2
1MC-067	SA	Containment SA (Cnmt. Press)	2
1MC-068	PS	PS - CNTM ATMOS	2
1MC-069	RE	Cont. Equipment Drains RE	2
1MC-070	RF	Containment Floor Drains RF	2
1MC-071	HG	Hydrogen Recombiner from Cont.	2
1MC-072	HG	Hydrogen Recombiner to Contnt.	2
1MC-073		Spare	2
1MC-074		Decontamination	2
1MC-075		Spare	2
1MC-076	RH	RHR P.R.V. (Drain)	1
1MC-077		Spare	2
1MC-078	CC	Component Cooling Water	2
1MC-079	SF	Suppression Pool Clean-Up	1
1MC-080		Spare	2
1MC-081	FP	Fire Protection	2
1MC-082	FP	Fire Protection	2
1MC-083		Spare	2
1MC-084		Spare	2
1MC-085	CY	Cycle Condensate	2
1MC-086	RT	RWCU to Condenser	7

NO.	SYSTEM	DESCRIPTION	JUSTIFICATION
1MC-087	RH	RHR "A" P.R.V.	1
1MC-088	CC	CCW Return	2
1MC-089	RH	RHR Ht. Exch. Shell Vent	2
1MC-101	VR	Cont. Vent Air Supply	2
1MC-102	VQ	Cont. Vent Air Purge & Exhaust	2
1MC-103	WO	Cont. Cooling Chilled Water Supp.	2
1MC-104	WO	Cont. Cooling Chilled Water Return	2
1MC-105		Spare	2
1MC-106	VR	Continuous Cnmt. Purge Air Exh.	2
1MC-107	VP	Drywell Cooling Water Supp.	3
1MC-108	VP	Drywell Cooling Water return.	3
1MC-109	VP	Drywell Cooling Water Supp.	3
1MC-110	VP	Drywell Cooling Water return.	3
1MC-111		Spare	2
1MC-112		Spare	2
1MC-113	VR	Cnmt. Purge Air Supply	2
1MC-114		Spare	2
1MC-115		Spare	2
1MC-116	SC	Standby Liquid Control	2
1MC-150	CM	Cnmt. Pressure Monitors	1, 2*
1MC-151	CM	Cnmt. Pressure Monitors	2
1MC-152	CM	Containment Monitoring	2
1MC-153	CM	Drywell Pressure	2
1MC-154		Spare	2
1MC-155		spare	2
1MC-156	VG	Conmnt.Pressure (SGTS Train A)	1, 2*
1MC-157	CM	Suppression Pool Water Level	1, 2*
1MC-158		Spare	2
1MC-159		Spare	2
1MC-160	CM	Containment Monitoring System	1
1MC-161		Spare	2
1MC-162		Spare	2
1MC-163		Spare	2
1MC-164	SM	Suppression Pool Makeup	1, 2*
1MC-165	VR	Containment Differential Pressure	2
1MC-166	HG	Hydrogen Recombiner from Comnt	2
1MC-167	VG	Contmnt Pressure (SGTS Train B)	2
1MC-168	CM	Containment Differential Pressure	2
1MC-169	VR	Contmnt. Purge Damper Control	2
1MC-170		Spare	2
1MC-171	SM	Suppression Pool Makeup	1, 2*
1MC-172	RH	RHR Ht. Exch. Shell Vent	2
1MC-173	CM	Containment Monitoring System	2
1MC-174		Spare	2
1MC-175		Spare	2
1MC-176		Spare	2
1MC-177	RI	Supp. Pool Water Level (RCIC)	1

NO.	SYSTEM	DESCRIPTION	JUSTIFICATION
1MC-178		Spare	2
1MC-179	HP, SM	H.P. Core Spray System & Suppr Pool Make-Up	1
1MC-180	HP	H.P. SUP. Pool LEVEL	1, 2*
1MC-181	SM	Supp. Pool Water Level	1
1MC-182		Spare	2
1MC-183	CM	Supp. Pool Water Level	1, 2*
1MC-184		Spare	2
1MC-200	RI	Supp. Pool Water Level (RCIC)	1,2*
1MC-201		Spare	2
1MC-202		Spare	2
1MC-203	CM	Containment Monitoring	2
1MC-204	SX	S/D Service Water	5
1MC-205	SX	S/D Service Water	5
1MC-206	IA	Instrument Air	2
1MC-207		Spare	2
1MC-208	SX	S/D Service Water Return	5
1MC-209		Spare	2
1MC-210	PS	Post Accident Sample	2
1MC-211		Spare	2

*Multiple lines share the penetration. Some, but not all, are water filled during normal operation. The lines not water filled are dependent on the other listed justification.

Justification Codes:

- 1 Line cannot pressurize due to arrangement of containment isolation valves. These lines either have no inboard isolation valve or one of the containment isolation valves is a check valve installed to prevent pressure buildup inside the penetration.
- 2 Line is not water filled during normal operation. The process fluid is steam or air, or the penetration is spare, or it is abandoned.
- 3 A relief valve or expansion chamber is installed between the isolation valves, or an air operated globe valve provides pressure relief.
- 4 Process operating temperature is hotter than containment atmosphere temperature post-LOCA. Line will cool after a plant trip.
- 5 Valves are not closed post-LOCA. Surveillance procedures have been modified to cycle one valve at a time
- 6 Inboard valve is a flex wedge gate with the inboard disk drilled or otherwise bypassed.
- 7 ASME Appendix F methodology used to demonstrate pipe will plastically deform rather than burst.